

Name

Service No.

Address 47 Circle Road

Lot #9

Location

Kind of Pipe J.M.Lucente Permit #A281

Size

Size of Main

Repair—Renewal—New Service

Location

Date

Material

Amount

Total

Date

Amount


5-7-66 47' 6" Transite pipe

DATE _____

TOWN OF LEXINGTON — BOARD OF PUBLIC WORKS

SEWER DIVISION

Sketch of Service Here **47**

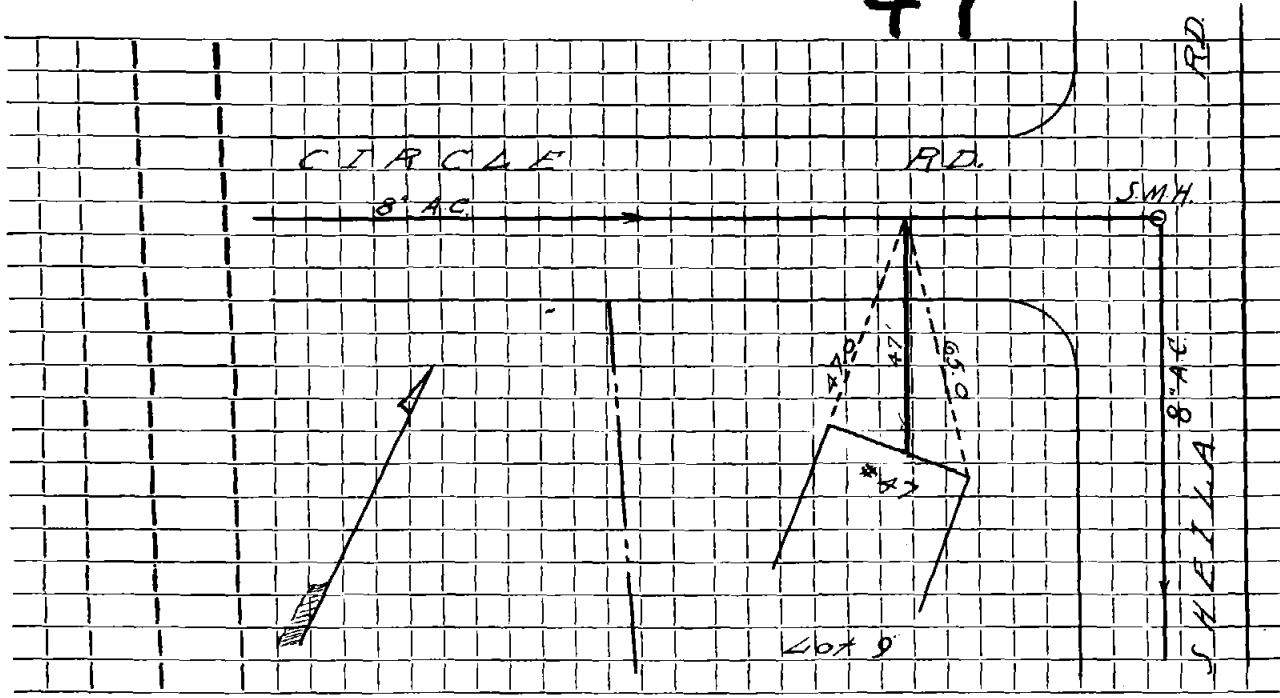

Connection made in Street. Work completed

Remarks:
.....
.....