




DATE 10/19/18

TOWN OF LEXINGTON — BOARD OF PUBLIC WORKS  
SEWER DIVISION

Sketch of Service Here

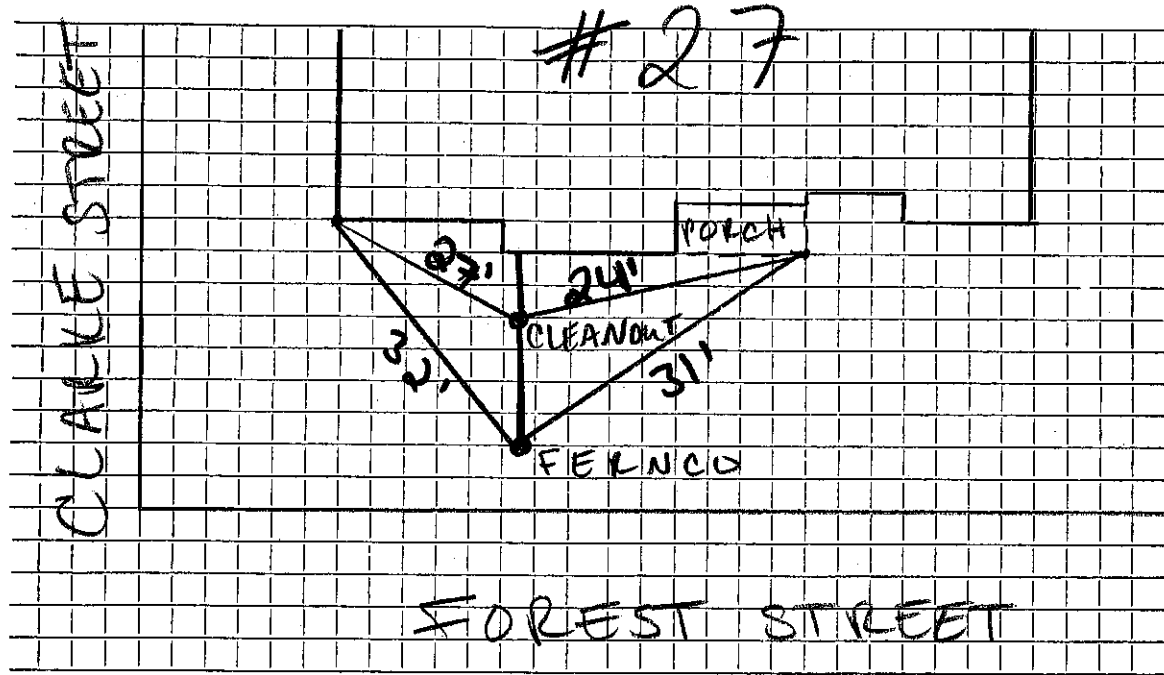

Connection made in Forest Street. Work completed .....

Remarks: House #27 Clarke St