

Name

Service No. 169

Address

Location 12 Clarke Street

Kind of Pipe

Size

Size of Main

Repair—Renewal—New Service

Location

Date

Material

Amount

Total

Date

Amount

1927

Labor

**TOWN OF LEXINGTON—BOARD OF PUBLIC WORKS**  
**SEWER DIVISION**

DATE \_\_\_\_\_

NO. \_\_\_\_\_


The undersigned applies for the construction of a particular sewer connecting No. 12 Clarke St. Street and hereby agrees to comply with the Rules and Regulations governing the construction and use of Particular Sewers, as now or at any future time established by the Board of Selectmen.

Am't. of Estimate \$ \_\_\_\_\_

Am't. Paid \$ \_\_\_\_\_

\_\_\_\_\_ Owner

Sketch of Service Here

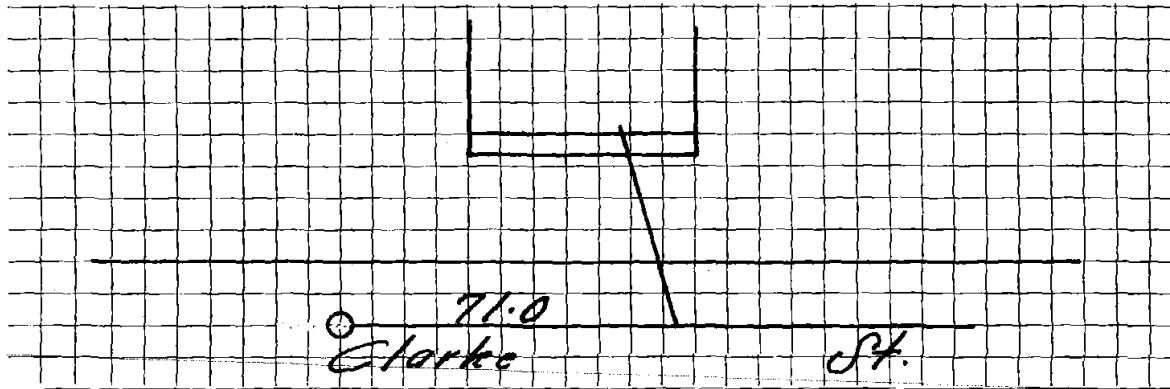

Connection made in \_\_\_\_\_ Street.

Work completed \_\_\_\_\_ 19\_\_

Remarks: