

Name Tilfer Construction Company

Service No. 48

Address 16 Clarke Street

Location

Comm. 11-18-57

Kind of Pipe

Size

Size of Main

Repair—Renewal—New Service

Location

Date	Material	Amount	Total	Date	Amount
5/20/57	Labor	73 22		4-18-57	Deposit
	10% overhead	7 32	80 54	11-18-57	Refund
	58' - 6" Transite pipe @ .7020		40 71		
	15x3 Patch		15 00		
	1½ hrs. Town Shovel @ 6.50		9 75		
	2 hrs. Trucking @ .75		1 50		
			147 50		
	RENEWAL INSIDE - CLEARWAY #4485				
11/7/83	24' Cast Iron Poured Joints				
	Repair From Cast 4" to Transite				
	Labor			10-24-83	S.B. 70' Down from M.H. on Raymond St
				7-8-89	S.D.

TOWN OF LEXINGTON—DEPT. OF PUBLIC WORKS

SEWER DIVISION

DATE.....

NO.


The undersigned applies for the construction of a particular sewer connecting No.....
 Street and hereby agrees to comply with the Rules and Regulations governing the construction and use of Particular
 Sewers, as now or at any future time established by the Board of Selectmen.

Am't of estimate \$.....

Am't Paid \$.....

..... Owner

Sketch of Service Here **16**

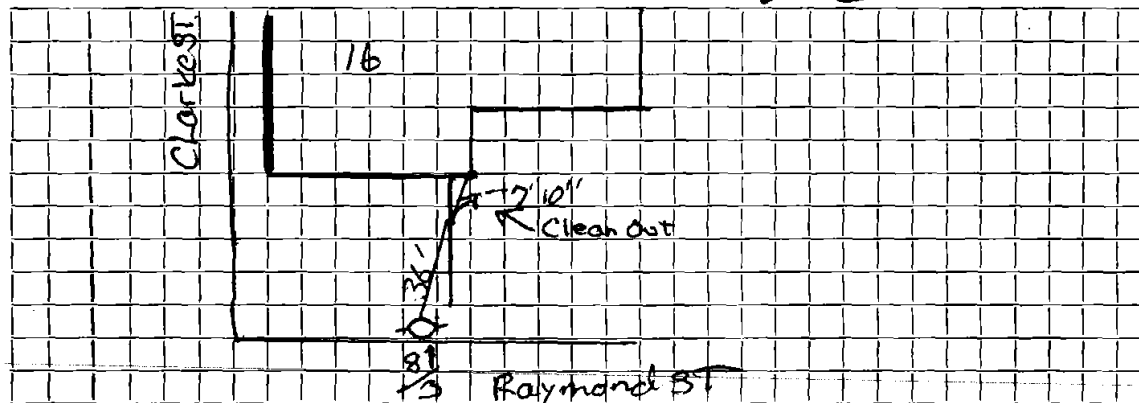

Connection made in..... Street.

Work completed.....19..

Remarks: **Original Service 1929**