

Name *Peter Kelley*

Service No.

Address *26 Clark Street*

Location

Kind of Pipe

Size

Size of Main

Repair—Renewal—New Service

McLaughlin #0066

Location

Date		Material	Amount	Total	Date	Amount	
7/11/90	125'	6" PVC					
	6'	4" PVC					
		4 x 6 Reducer (Fernco)					




DATE 7/11/90
P.A.B

TOWN OF LEXINGTON — BOARD OF PUBLIC WORKS

SEWER DIVISION

Sketch of Service Here **26**

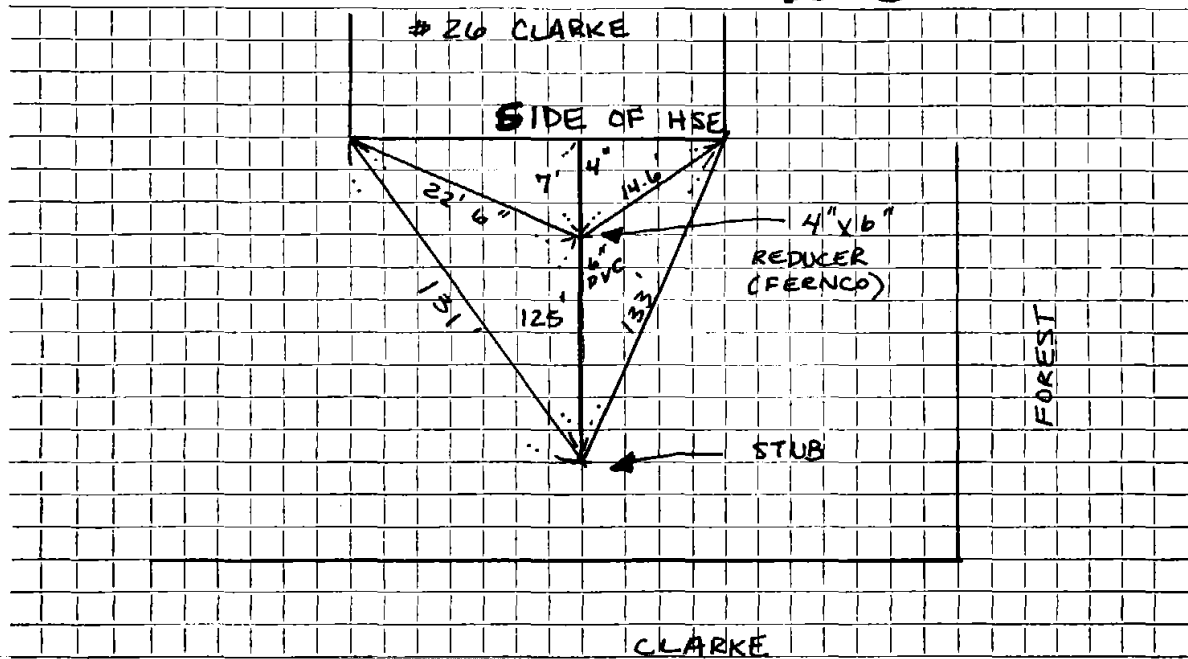

Connection made in CLARKE Street. Work completed

Remarks: ... INSPECTED: P.A. BARROWS

..... CONTRACTOR: J. MCLAUGHLIN