

Name William Sullivan

Service No. 35

Address 36 Clark Street

## Location

Kind of Pipe

Size

Size of Main

Repair—Renewal—New Service Sibley #535 *W.L. #4545*

Location MAR 18 1968

Date		Material	Amount		Total	Date		Amount	
5-19-67	29'	6" Transite pipe				5-2-67	<i>Deposit</i>		175 00
	10'	4" Cast Iron pipe				4-11-68	<i>Paid</i>		207 28
									382 28
5/11/67		Labor	98.08						
5/11/67		"	69.60						
6/14/67		"	12.24						
6/14/67		"	12.54						
6/23/67		"	6.28	198 74					
		10% O.H.		19 87	218 61				
	25'	6" Transite pipe @ .88			22 00	10	Hrs. Trucking @ 3.00	30 00	
	2-	12" Nipples			2 42	8½	" Shovel @ 6.50	55 25	
	1-	90 Elbow			3 49	4	" Compressor	20 00	
	6	Ton gravel @ 1.10			6 60	1	" Roller	3 00	
	1-	8+6 Saddle			5 50			382 28	
	2½	Ton hot top @ 580			14 50				
	1-	6" Nipple			91				

DATE \_\_\_\_\_

# TOWN OF LEXINGTON — BOARD OF PUBLIC WORKS

## SEWER DIVISION

PARMER ST

FOREST ST  
S.M.H.  
S.M.H.


Sketch of Service Here **36**

S.M.H.

8" V.C.

CLARKE ST

ST

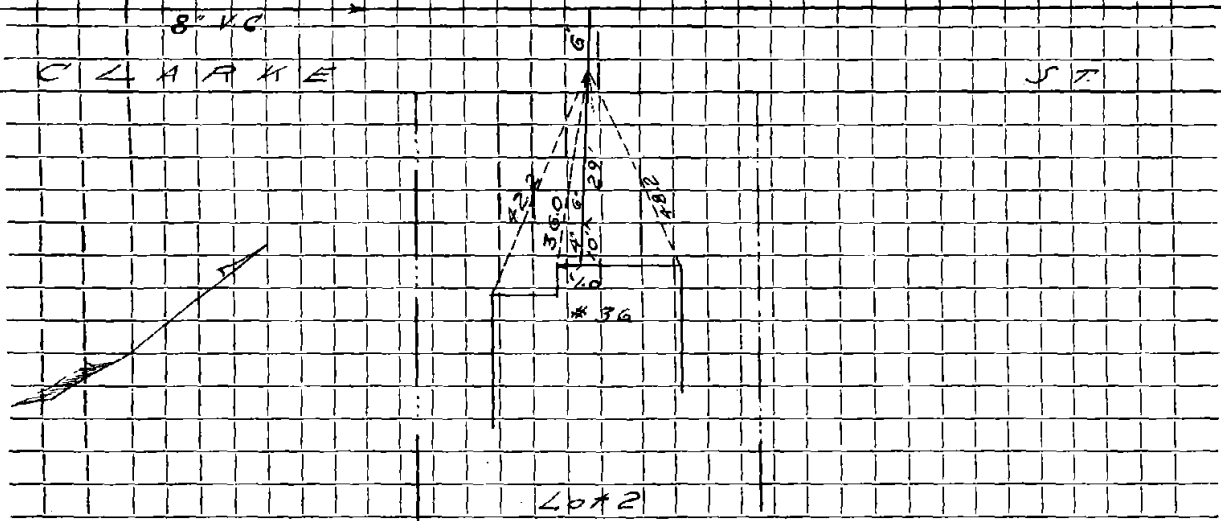

LOT 2

Connection made in ..... Street. Work completed .....

Remarks: .....  
.....  
.....