


DATE _____

TOWN OF LEXINGTON — BOARD OF PUBLIC WORKS
SEWER DIVISION

Sketch of Service Here **38**

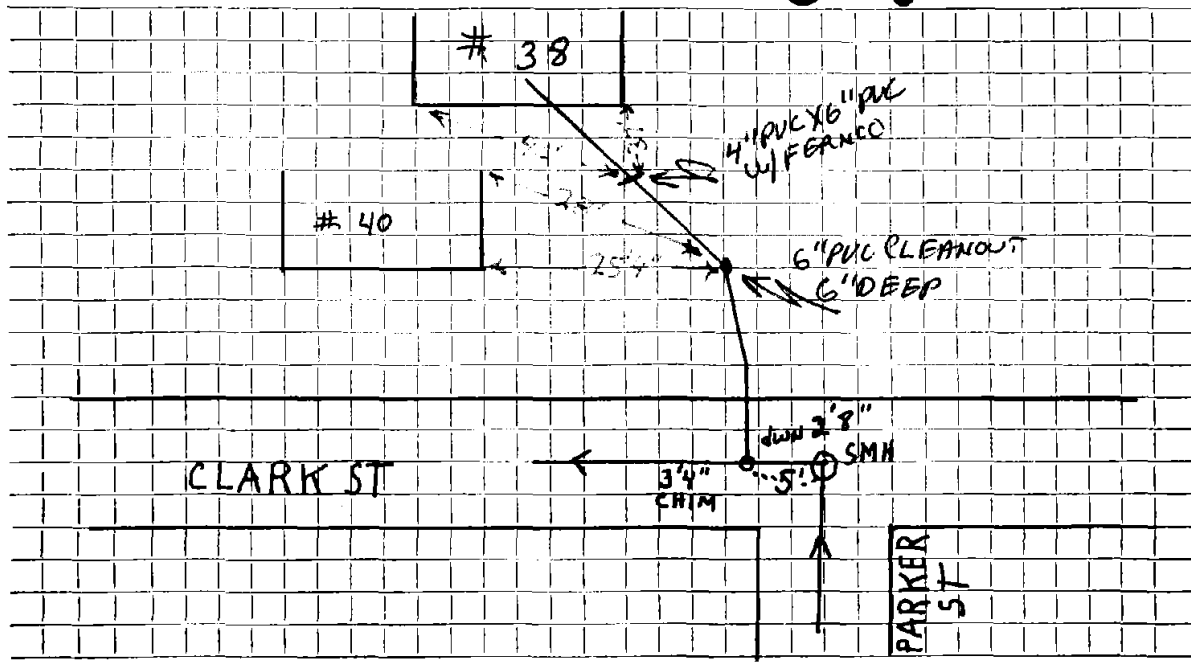

Connection made in CLARK ST Street. Work completed MARCH 31, 1906

Remarks: SEWER SERVICE IS VERY SHALLOW

.....
.....