


DATE _____

TOWN OF LEXINGTON — BOARD OF PUBLIC WORKS
SEWER DIVISION

Sketch of Service Here

41

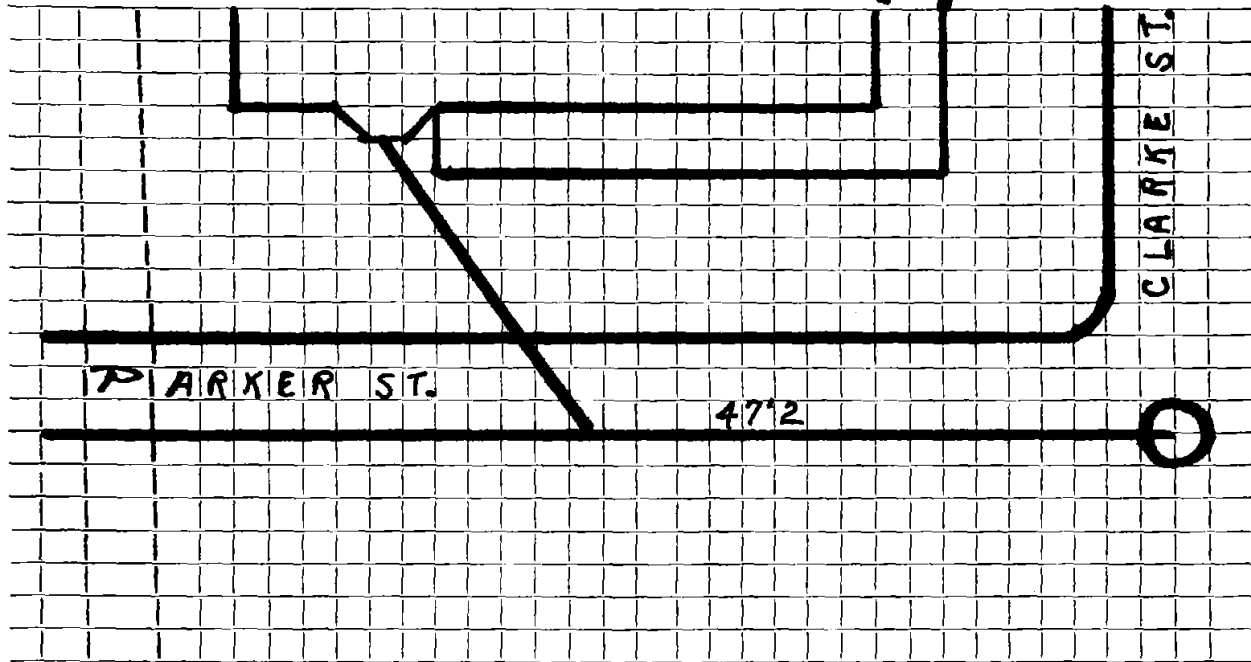

Connection made in _____ Street. Work completed _____

Remarks: *Original Service 1929*

.....
.....