


DATE _____

TOWN OF LEXINGTON — BOARD OF PUBLIC WORKS
SEWER DIVISION

Sketch of Service Here

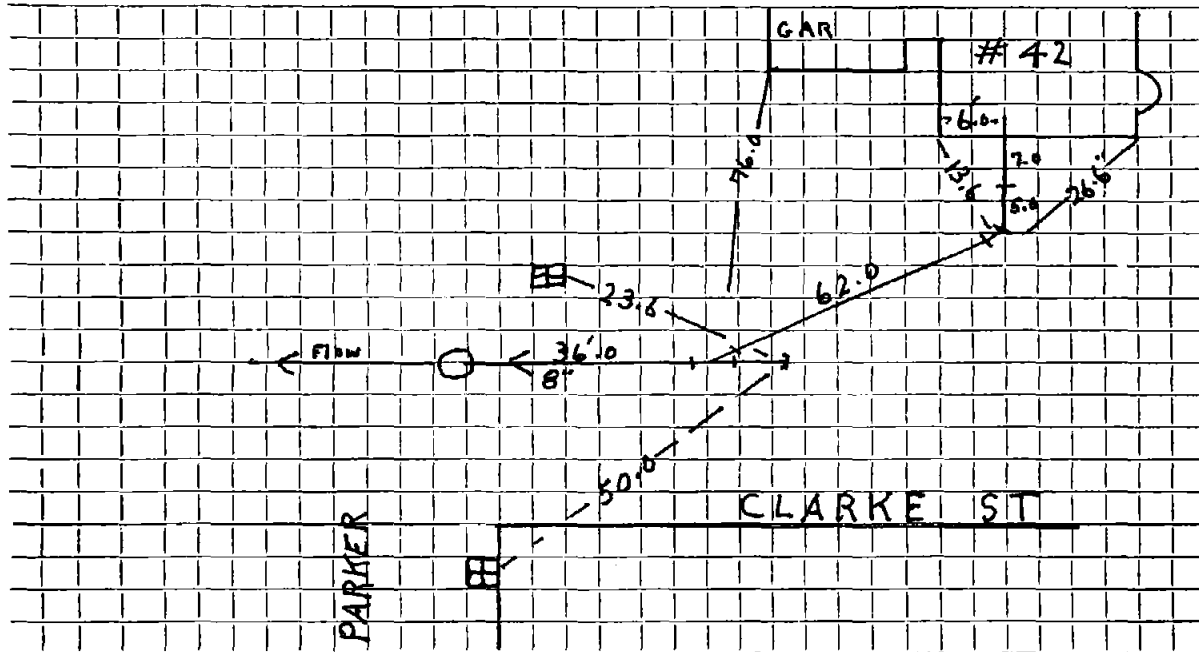

Connection made in Street. Work completed SEPT. 2002

Remarks: CAP. IS 3' Beyond Wye

.....
.....