

Name

Service No.

Address

Clelland

main extended for two

Location

Kind of Pipe

house lots

Size

Size of Main

Repair—Renewal—New Service

Location

Date

Material

Amount

Total

Date

Amount

8-12-04

28' - 8" PVC

1 - 8x8x6 TEE


1 - 8x8x6 WYE



DATE _____

TOWN OF LEXINGTON — BOARD OF PUBLIC WORKS
SEWER DIVISION

Sketch of Service Here

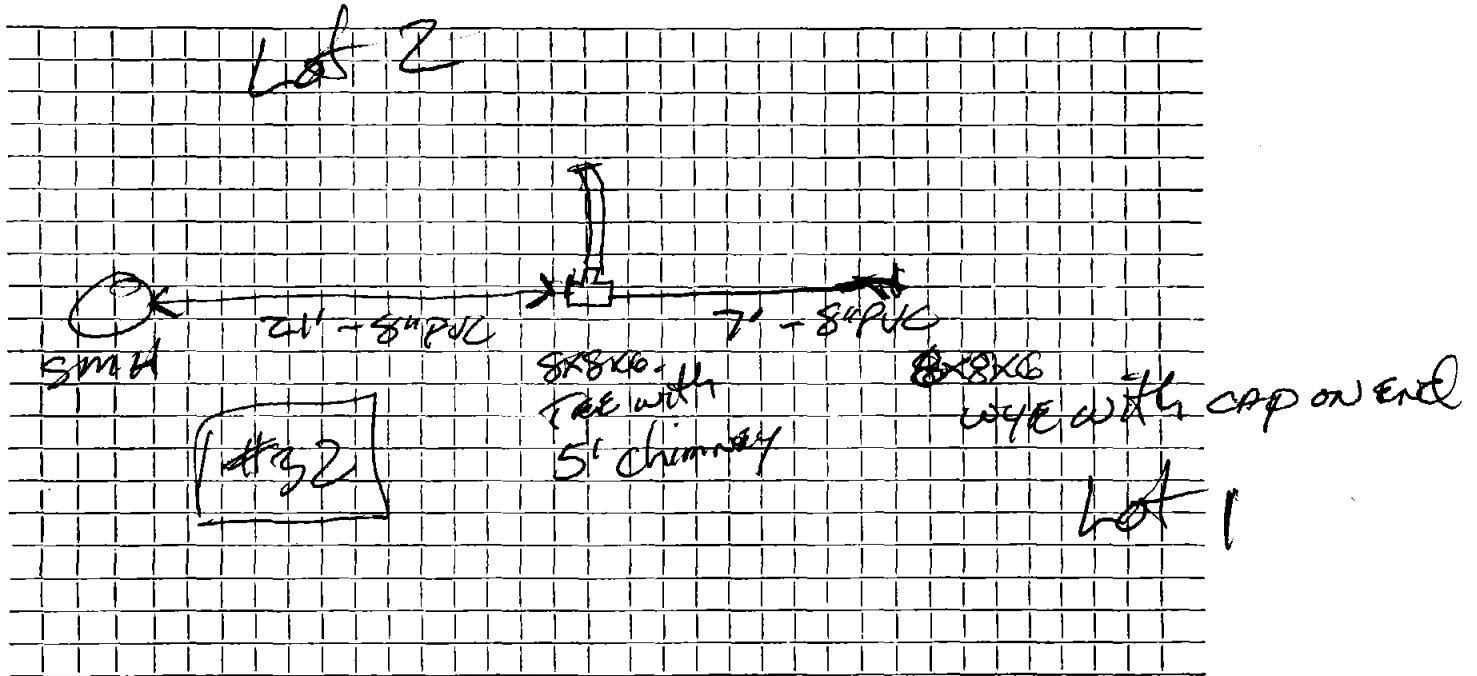

Connection made in Street. Work completed

Remarks: Main extended - 2 service connections installed