




DATE \_\_\_\_\_

TOWN OF LEXINGTON — BOARD OF PUBLIC WORKS

SEWER DIVISION

Sketch of Service Here

LOT #5

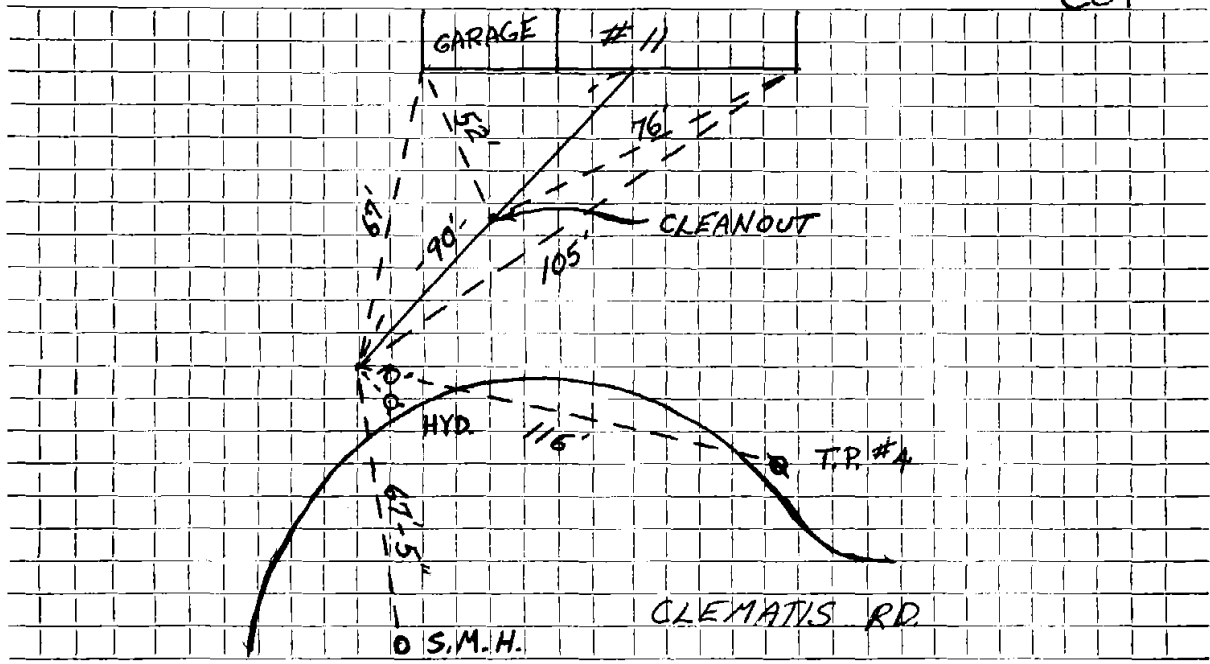

Connection made in CLEMATIS RD. Street. Work completed .....

Remarks: NOTE: NO OUTSIDE TIES .....

.....  
.....