




DATE \_\_\_\_\_

TOWN OF LEXINGTON — BOARD OF PUBLIC WORKS  
SEWER DIVISION

Sketch of Service Here

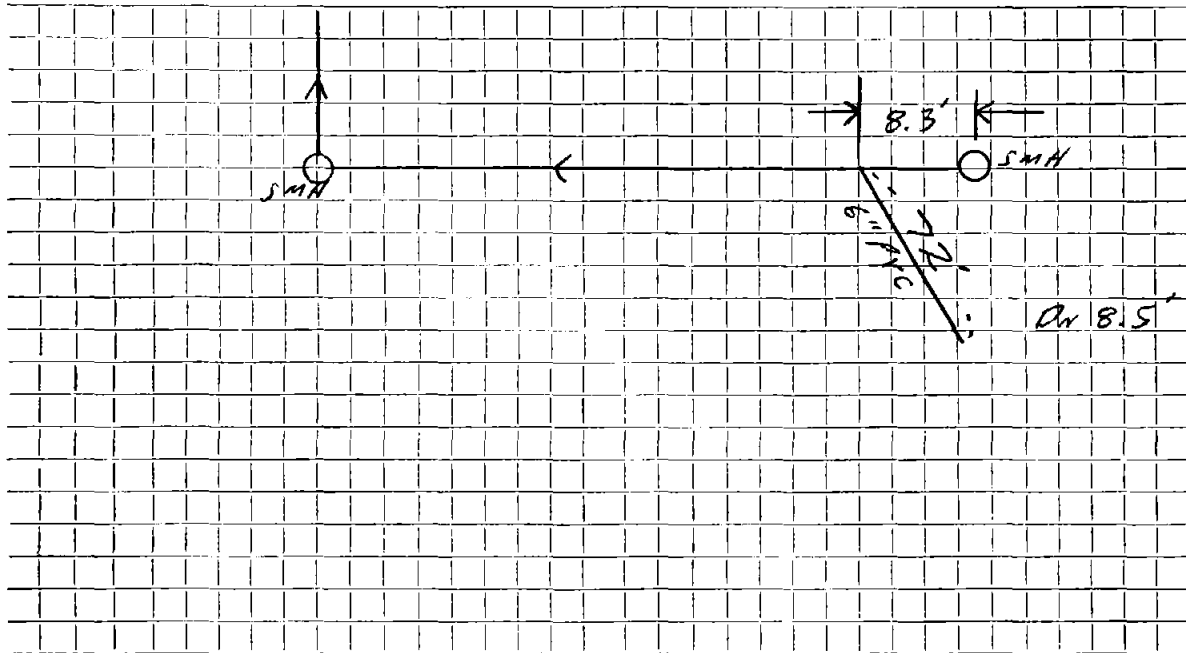

Connection made in *Clematis Road* ..... ~~Street~~ ..... Work completed .....

Remarks: .....  
.....  
.....