


DATE _____

TOWN OF LEXINGTON — BOARD OF PUBLIC WORKS
SEWER DIVISION

Sketch of Service Here **3**

LOT #2

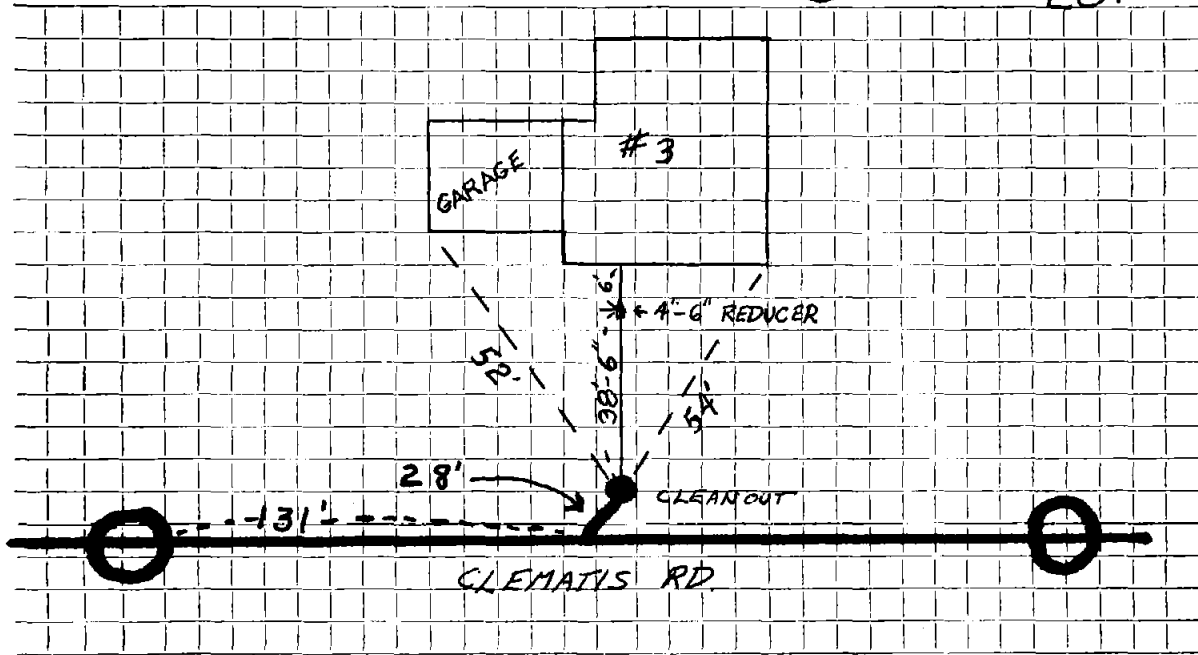

Connection made in .. CLEMATIS RD. Street. Work completed

Remarks: .. NO. OUTSIDE. TIES.