




DATE \_\_\_\_\_

TOWN OF LEXINGTON — BOARD OF PUBLIC WORKS  
SEWER DIVISION

Sketch of Service Here

4

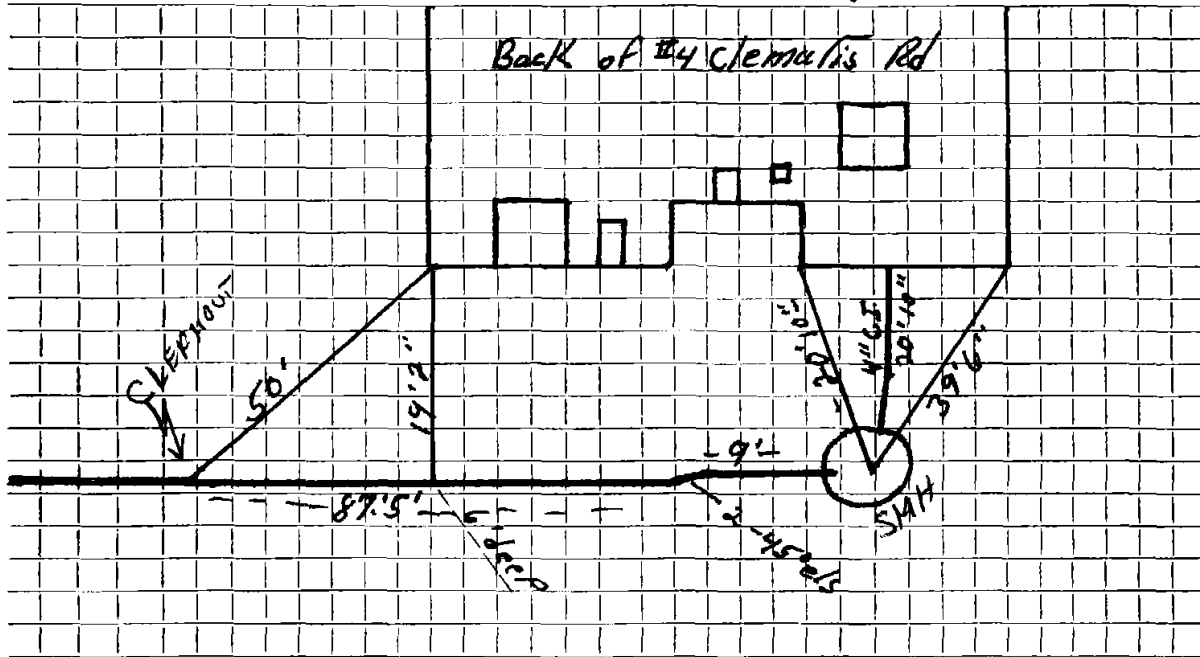

Connection made in EASEMENT TO RT #2 Street. Work completed Oct. 21, 1983

Remarks: .....

.....

.....