

Name *Francis Smith*

Service No. 25

Address *4 Clematis Road*

Location

Kind of Pipe *PVC*

Size *6"*

Size of Main *8" PVC*

~~Repair/Removal~~ **New Service** Arlex #4480


Location **FEB 27 1984**

Date	Material	Amount	Total	Date	Amount
<i>7-5 83</i>	<i>14 LF 6" PVC</i>	<i>224 00</i>		<i>8-4-83</i>	<i>Deposit</i>
<i>11-21-83</i>	<i>48' x 6" P.V.C.</i>				
	<i>1 6" Wye</i>				
					<i>OUTSIDE</i>
				<i>11/21/83</i>	<i>96' P.V.C.</i>

DATE 7-26-83

TOWN OF LEXINGTON — BOARD OF PUBLIC WORKS
SEWER DIVISION

Sketch of Service Here

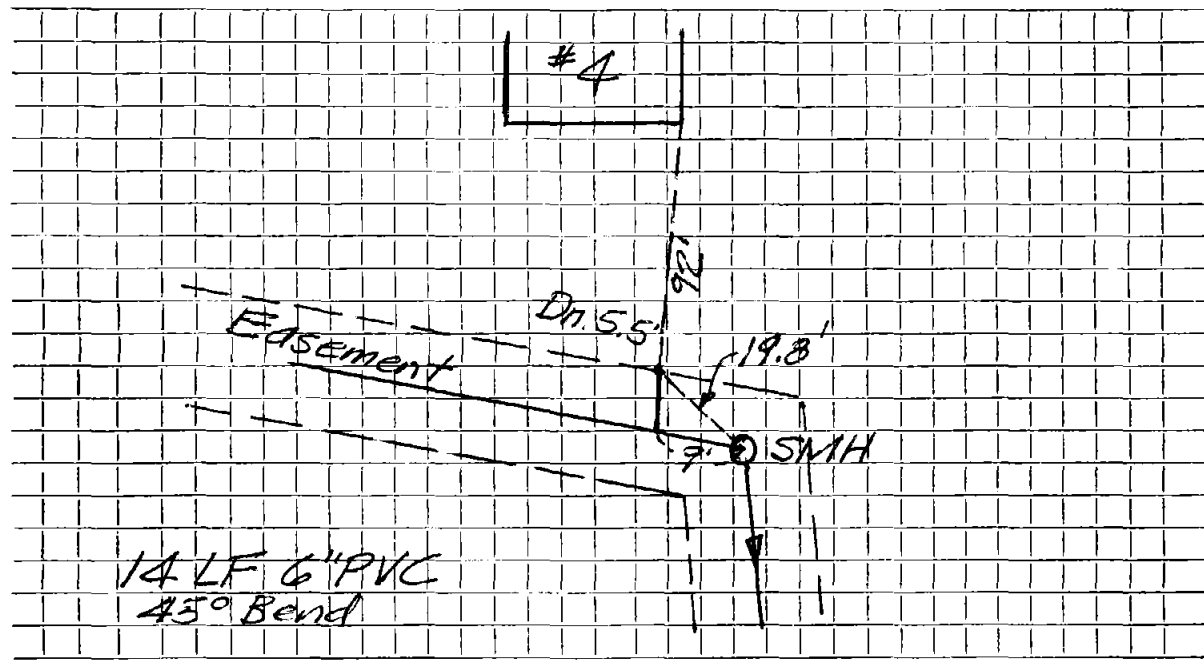

Connection made in Easement Street Work completed

Remarks: