


DATE _____

TOWN OF LEXINGTON — BOARD OF PUBLIC WORKS
SEWER DIVISION

Sketch of Service Here **7**

LOT #3

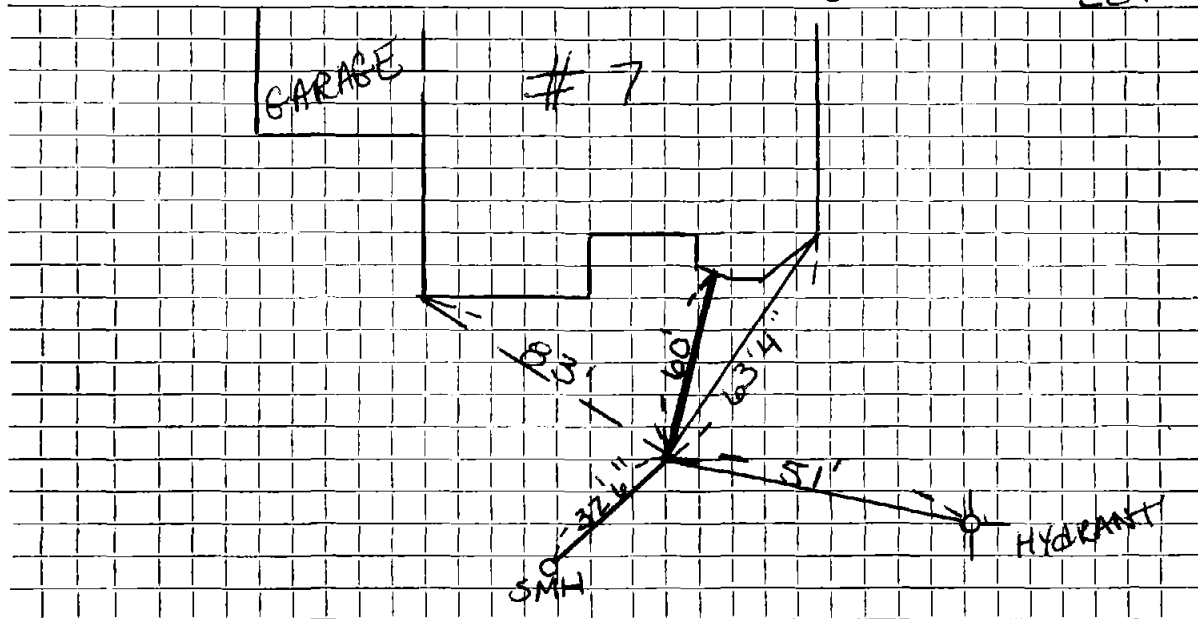

NOTE: NO OUTSIDE TIES

Connection made in CLEMATIS RD. Street. Work completed

Remarks:
.....
.....