


DATE _____

TOWN OF LEXINGTON — BOARD OF PUBLIC WORKS
SEWER DIVISION

Sketch of Service Here

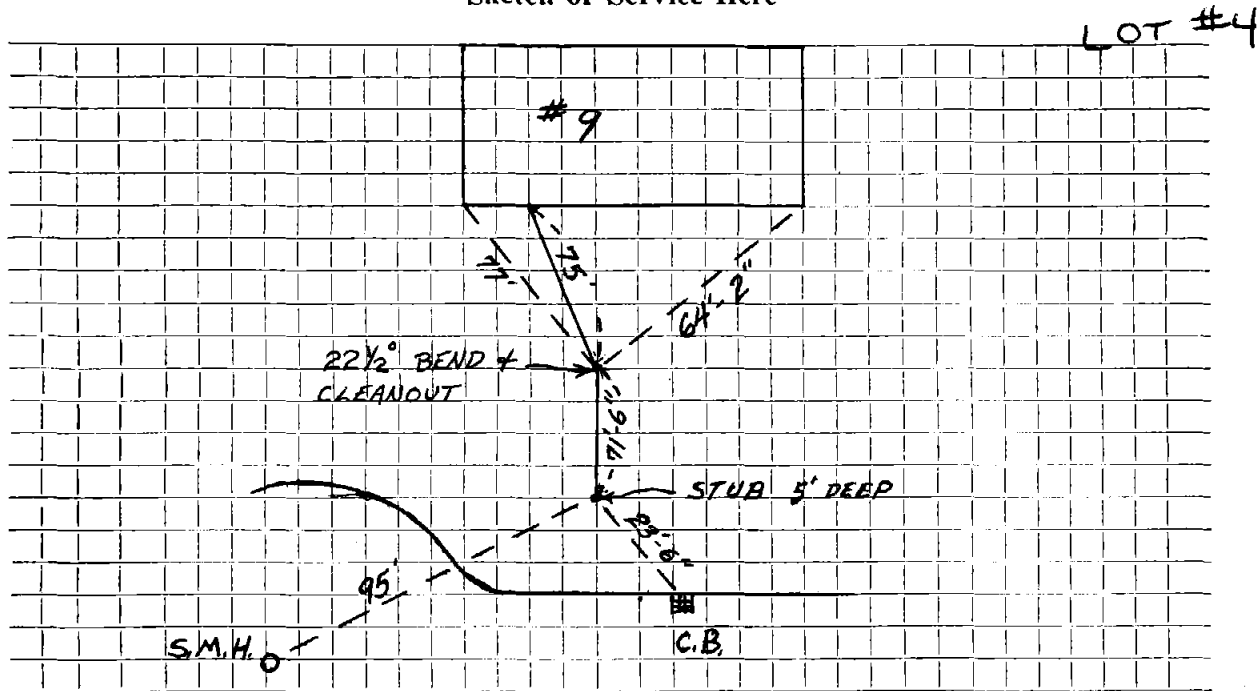

Connection made in CLEMATIS RD. Street. Work completed

Remarks: NOTE: NO OUTSIDE TIES