


DATE _____

TOWN OF LEXINGTON — BOARD OF PUBLIC WORKS
SEWER DIVISION

Sketch of Service Here

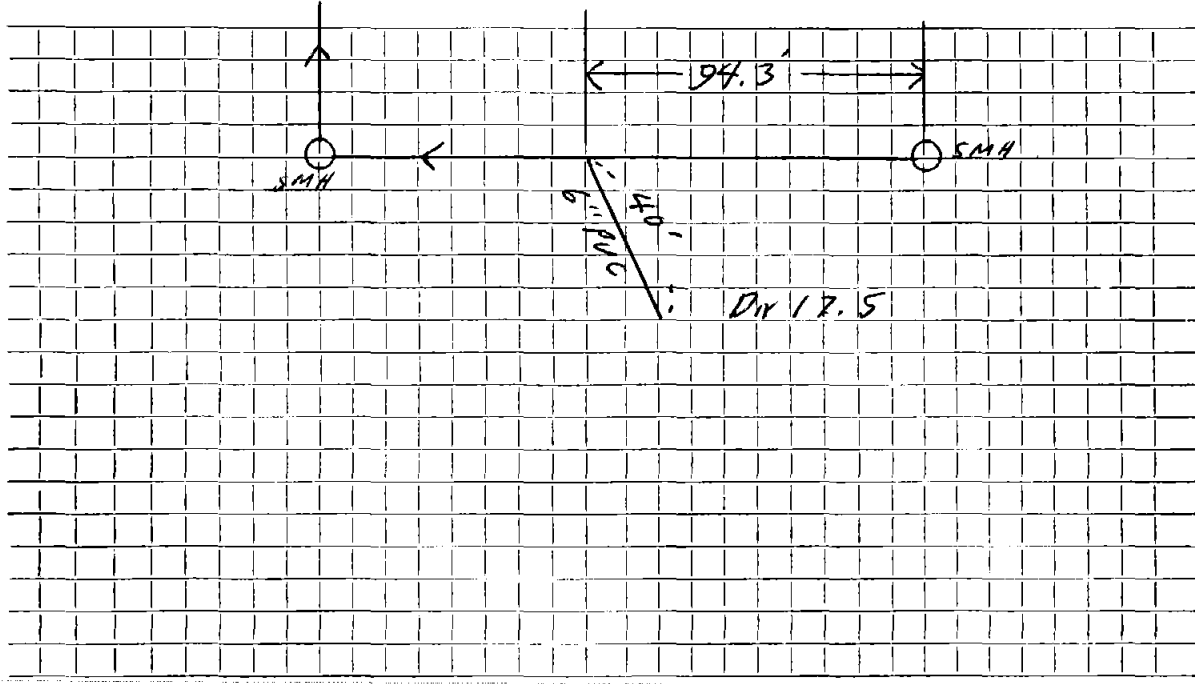

Connection made in Clematis Road ~~Street~~ Work completed

Remarks:
.....
.....

Name

Service No.

Address

9 Clematis Road (Lot 4)

Location

Kind of Pipe

PVC

Size

6"

Size of Main

8"

Repair—Renewal—New Service

Location

Date

Material

Amount

Total

Date


Amount

83 40' - 6" PVC

DATE _____

TOWN OF LEXINGTON — BOARD OF PUBLIC WORKS
SEWER DIVISION

Sketch of Service Here

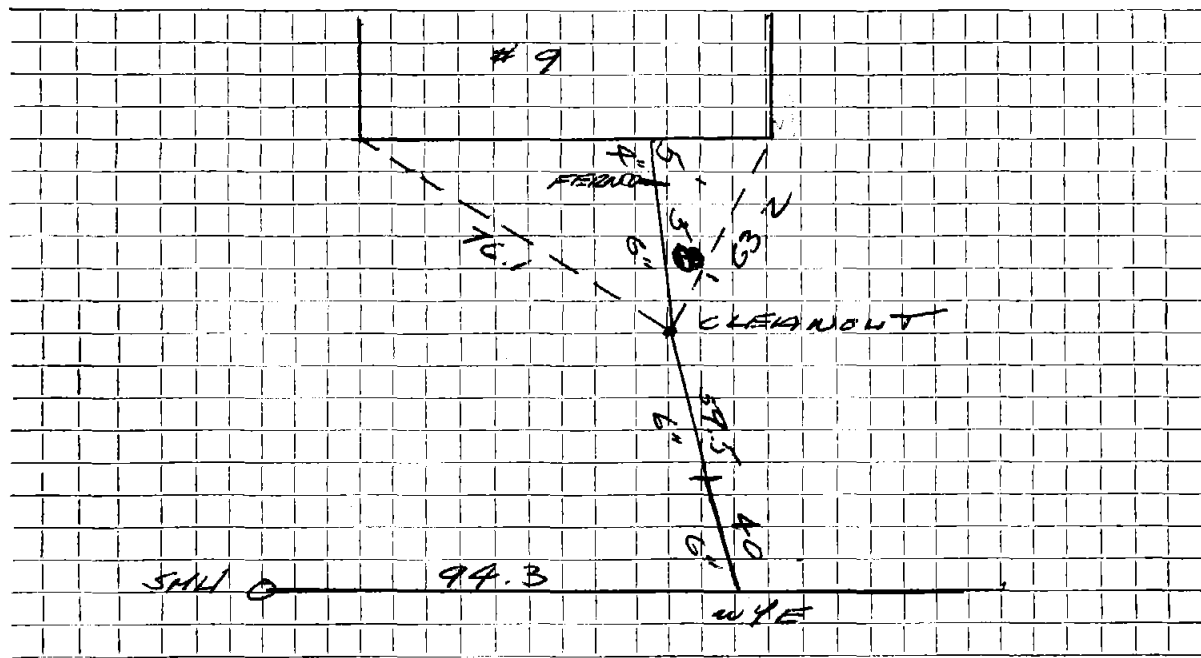

Connection made in CLEMATIS RD. Street. Work completed

Remarks:
.....
.....