


DATE June 17, 2020

TOWN OF LEXINGTON — BOARD OF PUBLIC WORKS
SEWER DIVISION

Sketch of Service Here

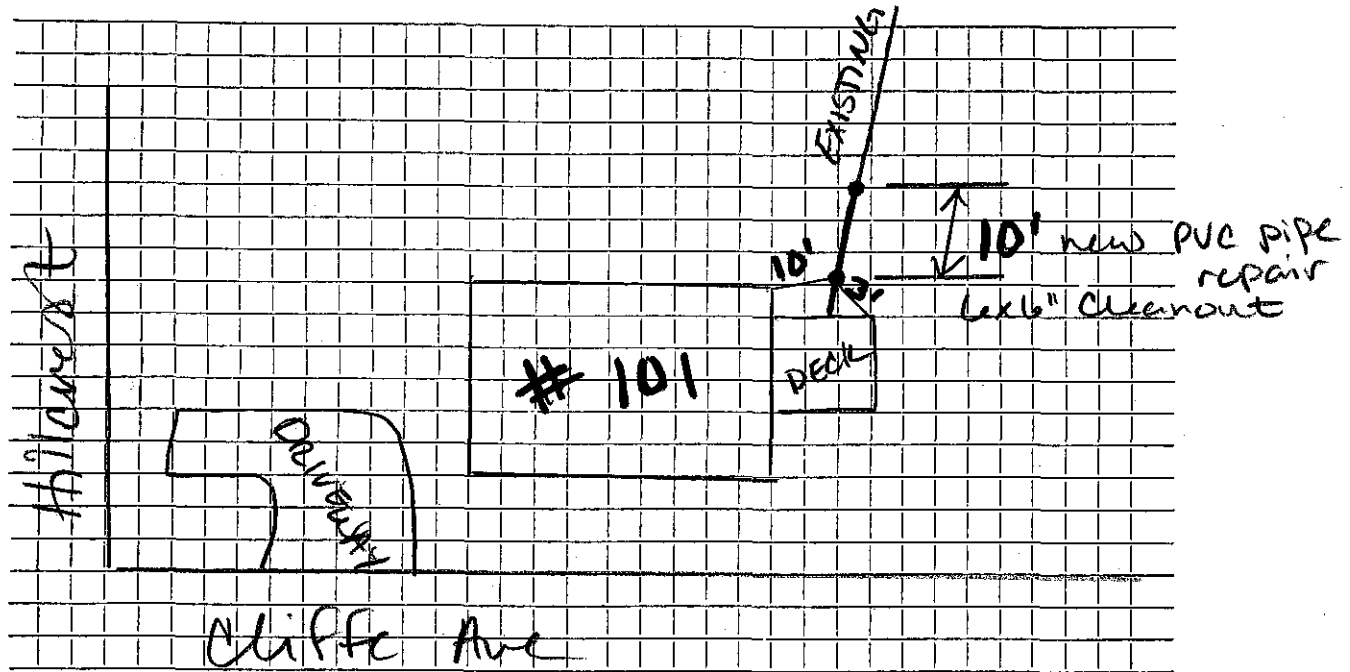

Connection made in Cliff Ave Street. Work completed

Remarks:
10' sewer repair
.....