

Name Joseph Dattoli

Service No. 71

Address 101 Cliffe Av.

Lexington, Mass.

Location

Kind of Pipe

Comp. y 2451

Size

Size of Main

~~Repair~~ ~~Renewal~~ - New Service

Location

Date	Material	Amount	Total	Date	Amount
8/27/51	Labor	18 73	18 73	July 8 51 Deposited	200 00
8/28/51	"	24 38	24 38		
8/30/51	"	33 45	33 45		
	10% overhead		7 66		
	144' 6" sewer pipe @ .342		49 24		
	1 6" elbow		1 88		
	1 6" Y		1 16		
	joint compound		8 64		
	7 hrs. Littlefield shovel		49 00		
	4 hrs. trucking		3 00		
8-15-63	Repair		197 14		
	12' 6" Transite				
	1 6" Labor Adapter				

101 Cliffe Ave. - Don't know trouble - has to dig up.

**TOWN OF LEXINGTON—DEPT. OF PUBLIC WORKS
SEWER DIVISION**

DATE

NO.

The undersigned **applies** for the construction of a particular sewer connecting No.
Street and hereby **agrees** to comply with the Rules and Regulations governing the construction and use of Particular
Sewers, as now or at **any** future time established by the Board of Selectmen.


Am't of estimate \$.....

Am't Paid \$.....

..... Owner

Sketch of Service Here

101

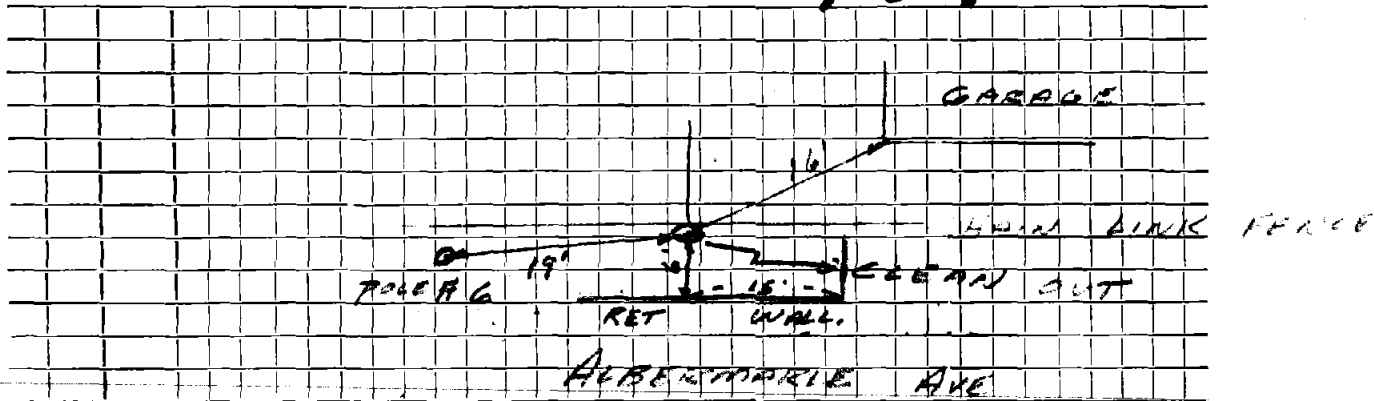

Connection made in Street.

Work completed 19..

Remarks:

