

Name Robert Caterino  
 Address 12 Cliffe Avenue

Service No. 34

Location *1-10 100 ft. main*

Kind of Pipe Size Size of Main

~~Repair~~ ~~Renewal~~ - New Service W. O. # 7769 Lexington Sewerage #1612

Location SEP 21 1970

Date	Material	Amount	Total	Date	Amount
6/4/70	Labor	65 90		5-28-70	150 00
6/17/70	"	17 89	83 79	9-21-70	1 39
	10% O.H.		8 38		148 71
	20'-6" Transite @.90		18.00		
	1-90° Elbow		5 65		
	½-Bag cement @ 1.55		39		
	½-Ton cold patch @6.00		1.50		
	½-Ton hot top @ 6.00		3 00		
	3-hrs.trucking @3.00		9 00		
	2-hrs.shovel @6.50		13 00		
	½-hr. compressor @5.00		2.50		
	½ hr. roller @ 3.00		1 50		
	Trailer		2 00		
			<u>\$ 148 71</u>		
6/11/70	30' 6" Transite pipe				
	10' 4" Cast Iron pipe				

*Deposit*  
*Refund*

RECOMMENDATION - 1/10/89


SERVICE APPEARS TO BE ~~P.O.~~  
BLUTTER ABOUT 12' AND ABOUT 70% RESPONSE  
AGAIN AND TRY TO PINPOINT PROBLEM.  
STIMMEL 6/2/86

DATE \_\_\_\_\_

TOWN OF LEXINGTON — BOARD OF PUBLIC WORKS

SEWER DIVISION

Sketch of Service Here

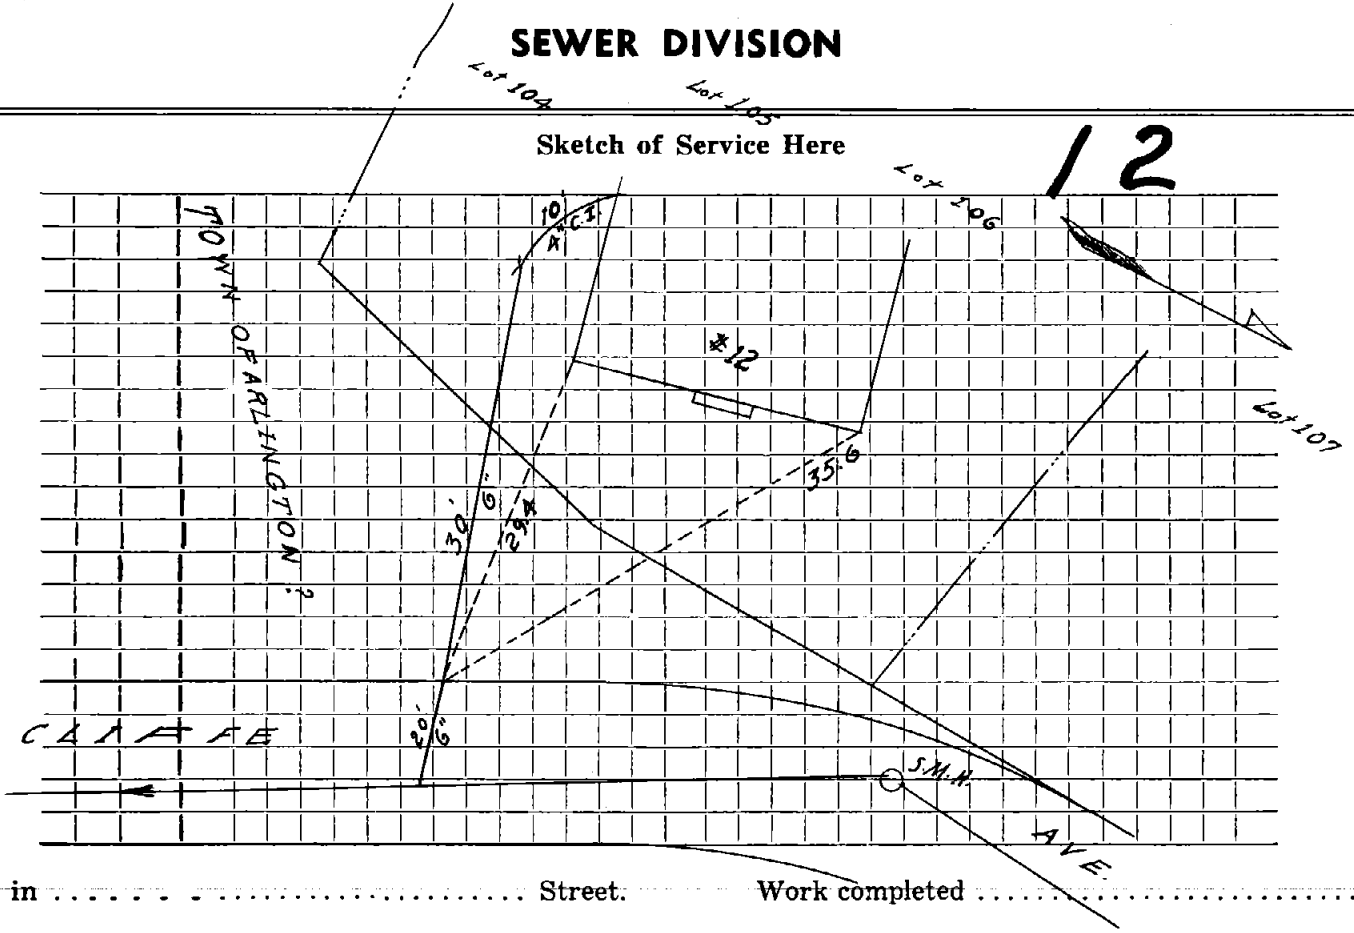

Connection made in ..... Street. Work completed .....

Remarks: .....  
.....  
.....