

Name Guy S. Hagar
 Address 15 Cliffe Ave.,

Service No. 37 / 81

Location 15 Cliffe Ave.,

Kind of Pipe Size Size of Main

Repair—Renewal—New Service

Location

Date	Material	Amount	Total	Date	Amount
11/25/35	84 hrs. labor @ 55¢	\$46 20		<i>Nov 14. 1935 Discontinued</i>	70 00
<i>Com. 475-33</i>	19 " " @ 60¢	<u>11 40</u>	57 60		5 33
<i>12-30-35 to Russell</i>	43' 6" Sewer Pipe @ 16¢	6 88			<u>75 33</u>
	Sulphur & Jute	2 10			
	3 hrs. @ Trucking \$1.25	3 75			
	Comp. 2 hrs. @ \$2.50	<u>5 00</u>			
			<u>17 73</u>		
			<u>\$75 33</u>		
	Labor			<i>Billed 12-21-35</i>	

Hadley Press, Inc., Lexington

TOWN OF LEXINGTON—BOARD OF PUBLIC WORKS
SEWER DIVISION

DATE Nov. 15, 1935

NO. _____


The undersigned applies for the construction of a particular sewer connecting No. 15 Cliff Ave Street and hereby agrees to comply with the Rules and Regulations governing the construction and use of Particular Sewers, as now or at any future time established by the Board of Selectmen.

Am't. of Estimate \$ 7.00

Am't. Paid \$ _____

Guy S. Hagar Owner

15 Sketch of Service Here

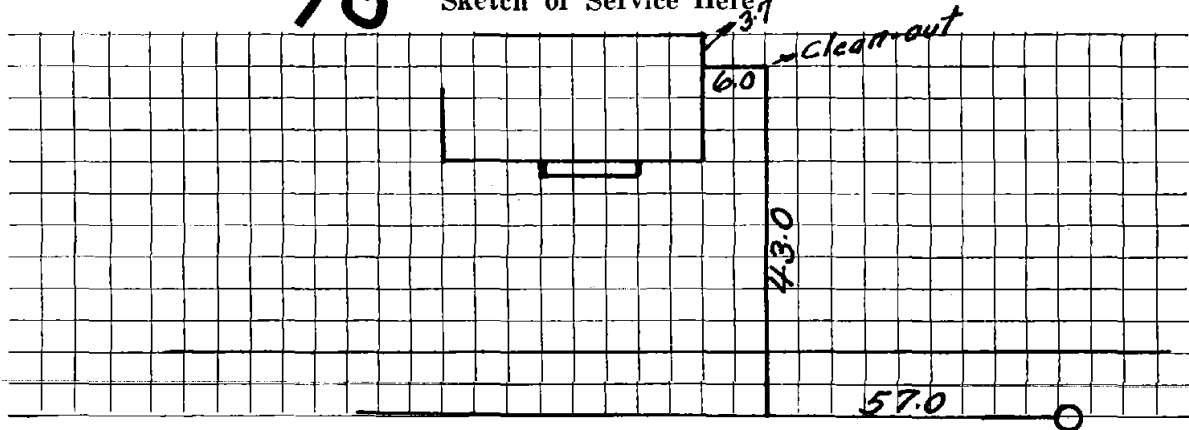

Connection made in _____ Street. Work completed _____ 19

Remarks: