

Name Mr. P. J. Crosby

Service No. 47 182

Address 20 + 22 Cliffe Ave.

Location

Kind of Pipe

Size

Size of Main

~~Repair - Renewal~~ - New Service

Location

Date	Material	Amount	Total	Date	Amount
	18' 3" Sewer Pipe @ .30	5 40			
	10' 4" Iron Pipe @ .50	5 00			
	Sulphur & Jute	72			
	Trucking	<u>75</u>	11 87	Jan 21 1931	Cash 44 36
10/30 47	Hrs. Labor @ .55	25 85			
4	" " @ .60	<u>2 40</u>	28 25		
	15% Overhead		<u>4 24</u>		
			<u>44 36</u>		
	Labor				

Hadley Press, Inc., Lexington

TOWN OF LEXINGTON—BOARD OF PUBLIC WORKS  
**SEWER DIVISION**

DATE \_\_\_\_\_

NO. \_\_\_\_\_

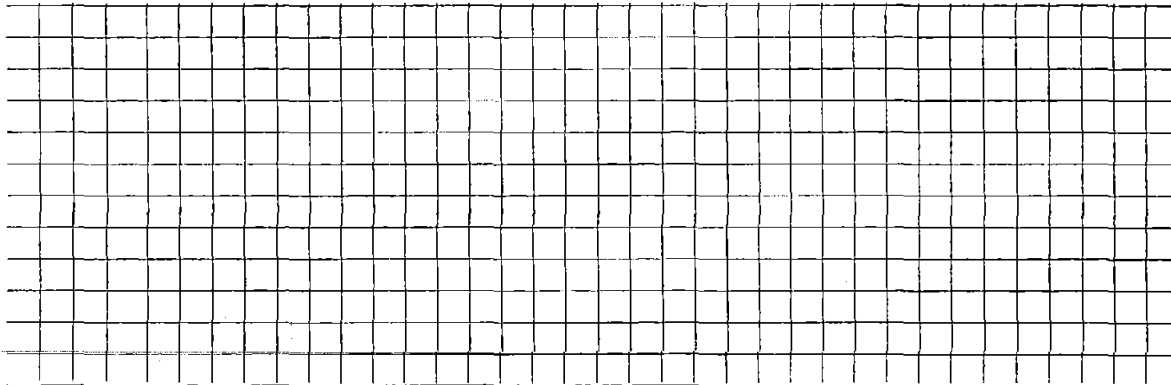
The undersigned applies for the construction of a particular sewer connecting No. \_\_\_\_\_ Street and hereby agrees to comply with the Rules and Regulations governing the construction and use of Particular Sewers, as now or at any future time established by the Board of Selectmen.

Am't. of Estimate \$ \_\_\_\_\_

Am't. Paid \$ \_\_\_\_\_

\_\_\_\_\_  
Owner

Sketch of Service Here

A large rectangular area filled with a grid of small squares, intended for a hand-drawn sketch of the sewer service location.

Connection made in \_\_\_\_\_ Street.

Work completed \_\_\_\_\_ 19

Remarks: