

Name Lexington Savings Bank

Service No. 11 / 83

Address 1774 Mass. Ave. , Lex.

Location 21 Cliffe Avenue

Kind of Pipe

Size

Size of Main

~~Repairs-Renewal~~—New Service

Location

Date

Material

Amount

Total

Date

Amount

1936

6/12

79 hrs. labor @ 55¢

43 45

June 10 1936

Deposited

90 00

30 " " @ 60¢

18 00

61 45

July 21, 1936

Refunded

3 15

10% Ovhd. on labor

6 15

86 85

45' 6" Sewer Pipe @ 16¢

7 20

Joint. comp.

1 20

Trucking

1 50

9 90

77 50

Trench Repairs

9 35

86 85

Labor

Hadley Press, Inc., Lexington

TOWN OF LEXINGTON—BOARD OF PUBLIC WORKS
SEWER DIVISION

DATE June 6 1936

NO. _____


The undersigned applies for the construction of a particular sewer connecting No. 21 Cliffe Ave Street and hereby agrees to comply with the Rules and Regulations governing the construction and use of Particular Sewers, as now or at any future time established by the Board of Selectmen.

Am't. of Estimate \$ _____

Am't. Paid \$ _____

Lexington Savings Bank
Edwin Bowditch Owner
Pres.

21 Sketch of Service Here

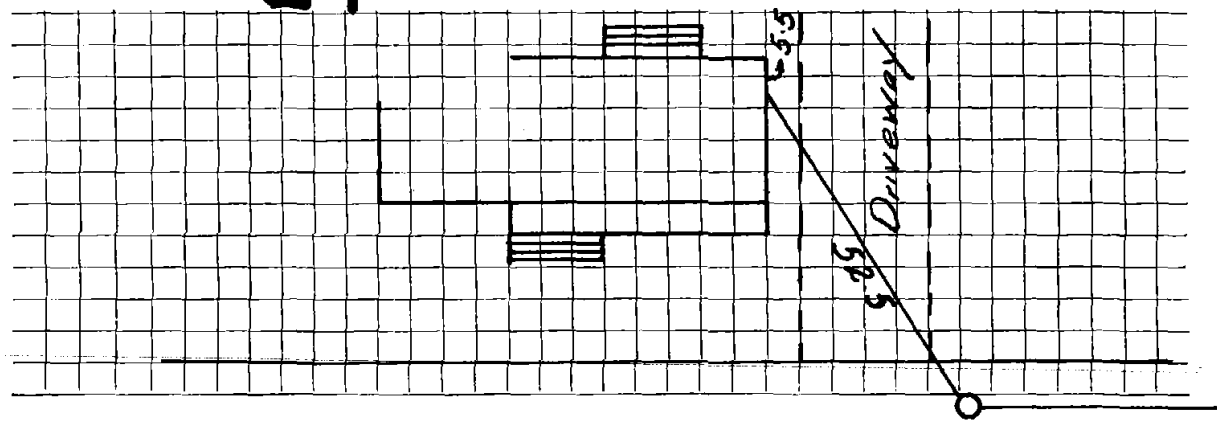

Connection made in _____ Street. Work completed _____ 19

Remarks: