

Name Mrs. Margaret E. Bartels

Service No. 43 185

Address 32  
40 Cliffe Ave.

Location

Kind of Pipe

Size

Size of Main

~~Repair~~ ~~Renewal~~ New Service

Location

Date	Material	Amount	Total	Date	Amount
P.6-16-31 for 40.24	25' 6" Sewer Pipe @.25 Sulphur & Jute Trucking	6 75 1 00 75	8 50	Oct. 19 1931 - Cash Mar. 8 1932 - Cash Dec. 28 1932 - Cash Jan. 9 1934 - Cash Nov. 10 1934 - "	10 - 40 5 - 40 5 - 10 - 40 <u>9 74</u> 39 74
11/21/48 30 2	Hrs. Labor @.55 " " @.60 15% Overhead	26 40 1 20	27 60 4 14 40 24 39 74		
4/13/55	1 4x6 Firnco 1 6x6 Firnco <del>Labor</del> 13' 6" PVC Bruce McKee				

Hadley Press, Inc., Lexington

TOWN OF LEXINGTON—BOARD OF PUBLIC WORKS  
SEWER DIVISION

DATE \_\_\_\_\_

NO. \_\_\_\_\_


The undersigned applies for the construction of a particular sewer connecting No. \_\_\_\_\_ Street and hereby agrees to comply with the Rules and Regulations governing the construction and use of Particular Sewers, as now or at any future time established by the Board of Selectmen.

Am't. of Estimate \$ \_\_\_\_\_

Am't. Paid \$ \_\_\_\_\_

*Mrs. Margaret E. Bartel* Owner

Sketch of Service Here

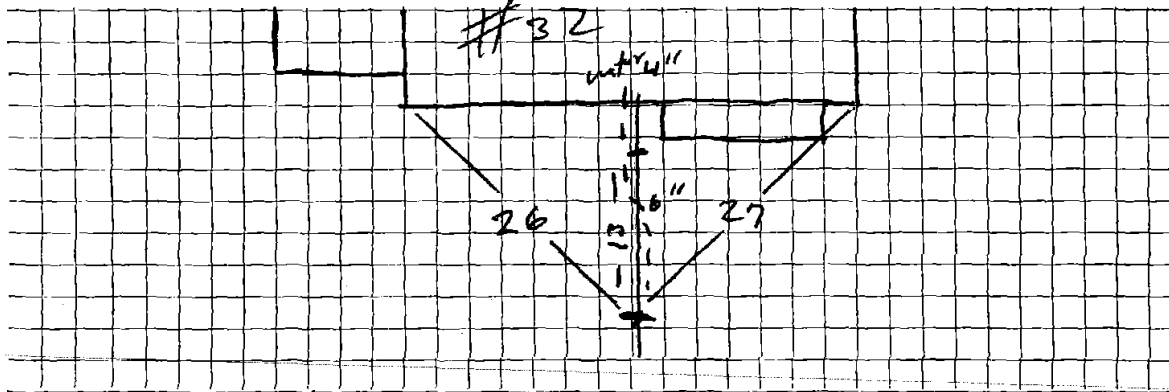

Connection made in Cliff Ave Street.

Work completed \_\_\_\_\_ 19

Remarks: *Water and Sewer same hole*

*Water crosses the sewer line*