

Name Rose Rosendorn  
 Address 36 Cliffe Avenue

Service No. 40

Location

Kind of Pipe

Size

Size of Main

Repair—Renewal—New Service

*Comm - 9-24-54*

Location

Date	Material	Amount	Total	Date	Amount	
5/14/56	Labor	25 50		5-2-56	Deposit	200 00
	10% overhead	2 55	28 05	7-24-56	Refund <del>A</del>	106 <del>72</del>
	50' 6" Sewer Pipe @ .3645		18 23			93 <del>72</del>
	Joint Compound		3 00			
	3 x 1 1/4 Patch		14 00			
	4 hrs. Littlefield @ 7.50		30.00			
			93 28			
					<i>* \$ 13.62 applied To S.H.C</i>	
					<i># 173 (1955)</i>	
	Labor					

**TOWN OF LEXINGTON—DEPT. OF PUBLIC WORKS**  
**SEWER DIVISION**

DATE.....

NO. ....

The undersigned applies for the construction of a particular sewer connecting No.....  
Street and hereby agrees to comply with the Rules and Regulations governing the construction and use of Particular  
Sewers, as now or at any future time established by the Board of Selectmen.


Am't of estimate \$.....

Am't Paid \$.....

..... Owner

---

**Sketch of Service Here**

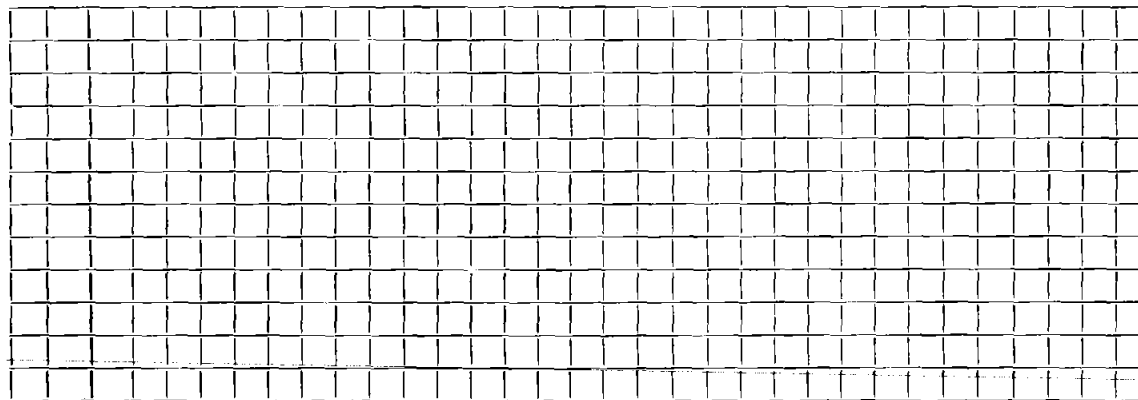

Connection made in..... Street.

Work completed.....19..

Remarks: