

Name Robert T. Burns

Service No. 177

Address 37 Cliffe Avenue

Location

Kind of Pipe

Size

Size of Main

~~Repair~~ ~~Renewal~~ ~~New Service~~ W.O.5925

Location AUG 5 1968

| Date     | Material                  | Amount | Total  | Date     | Amount |
|----------|---------------------------|--------|--------|----------|--------|
| 11-30-67 | Labor                     | 102.24 |        | 11-28-67 | 100.00 |
| 12-1-68  | "                         | 13.88  |        | 2-11-69  | 29.95  |
| 12-1-68  | "                         | 10.61  | 126.73 |          | 129.95 |
|          | 10% O.H.                  | 12.67  | 139.40 |          |        |
|          | 42' 6" Transite pipe @.88 |        | 36.96  |          |        |
|          | 1 22½° Transite bend      |        | 4.09   |          |        |
|          | 1 22½° Transite Elbow     |        | 2.35   |          |        |
|          | 200 Bricks                |        | 8.40   |          |        |
|          | 3 bags cement @1.55       |        | 4.65   |          |        |
|          | 1 frame & cover           |        | 10.50  |          |        |
|          | ½ ton Cold Patch @5.50    |        | 2.75   |          |        |
|          | 1 ton Hot Top             |        | 5.80   |          |        |
|          | 4 hr. Trucking @3.00      |        | 12.00  |          |        |
|          | 3 hrs. Town Shovel @6.50  |        | 19.50  |          |        |
|          | 2 hrs. Compressor @5.00   |        | 10.00  |          |        |
|          | ½ hr. Roller & Trailer    |        | 3.50   |          |        |
|          |                           |        | 259.90 |          | 29.95  |
|          | 259.90 x 124 yrs = 129.95 |        | 259.90 |          |        |

Name Joseph Gault

Service No. 29

Address 37 Cliffe Avenue

Location

Kind of Pipe

Size

Size of Main

~~Repair~~ ~~Renewal~~ ~~New Service~~ com. 7-18-55

Location

| Date    | Material                         | Amount | Total | Date     |                                  | Amount  |
|---------|----------------------------------|--------|-------|----------|----------------------------------|---------|
| 5/12/55 | Labor                            | 21 89  |       | 3-31-55  | Deposited                        | 125 00  |
|         | 10% overhead                     | 2 19   | 24 08 | 7-18-55  | Refunded                         | (38 42) |
|         | 50' - 6" sewer pipe @ .32        |        | 16 00 |          | <u>NON CHARGE</u>                | 86 58   |
|         | joint compound                   |        | 3 00  | 5/12/55  | Labor                            | 21 88   |
|         | 4 hrs. Littlefield shovel @ 7.50 |        | 30 00 | 5/12/55  | 54' - 6" sewer pipe @ .32        | 17 28   |
|         | 2 hrs. trucking @ .75            |        | 1 50  |          | joint compound                   | 3 24    |
|         | patching 12 x 3                  |        | 12 00 | 5/12/55  | 4 hrs. Littlefield shovel @ 7.50 | 30 00   |
|         |                                  |        | 86 58 |          | 2 hrs. trucking @ .75            | 1 50    |
|         |                                  |        |       |          | patching 54 x 3                  | 54 00   |
|         |                                  |        |       |          |                                  | 127 90  |
|         | Labor                            |        |       | 10/11/67 | roots                            |         |
|         |                                  |        |       | 11/15/67 | roots                            |         |
|         |                                  |        |       | 11/24/67 | roots                            |         |

TOWN OF LEXINGTON—DEPT. OF PUBLIC WORKS  
**SEWER DIVISION**

DATE.....

NO. ....

The undersigned applies for the construction of a particular sewer connecting No.....  
Street and hereby agrees to comply with the Rules and Regulations governing the construction and use of Particular  
Sewers, as now or at any future time established by the Board of Selectmen.


Am't of estimate \$. ....

Am't Paid \$. ....

..... Owner

---

**Sketch of Service Here**

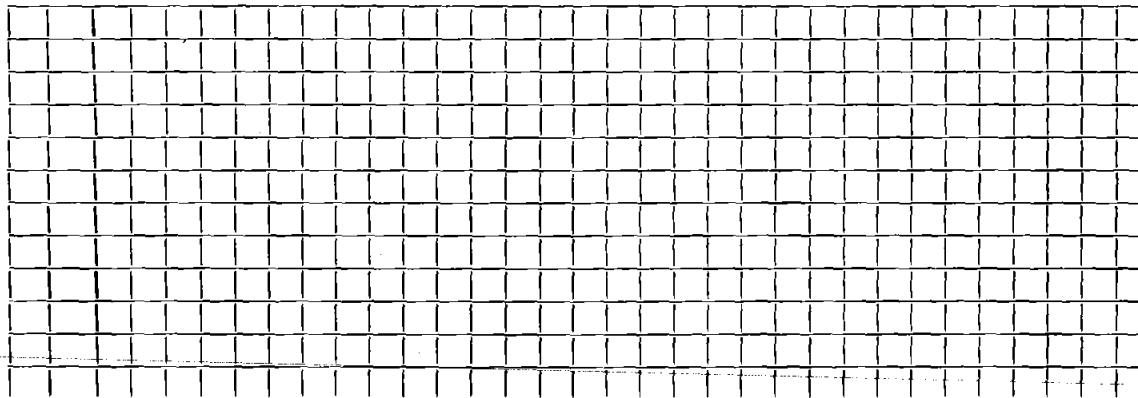

Connection made in . . . . . Street.

Work completed . . . . . 19..


Remarks:

DATE \_\_\_\_\_

**TOWN OF LEXINGTON — BOARD OF PUBLIC WORKS**

**SEWER DIVISION**

Sketch of Service Here

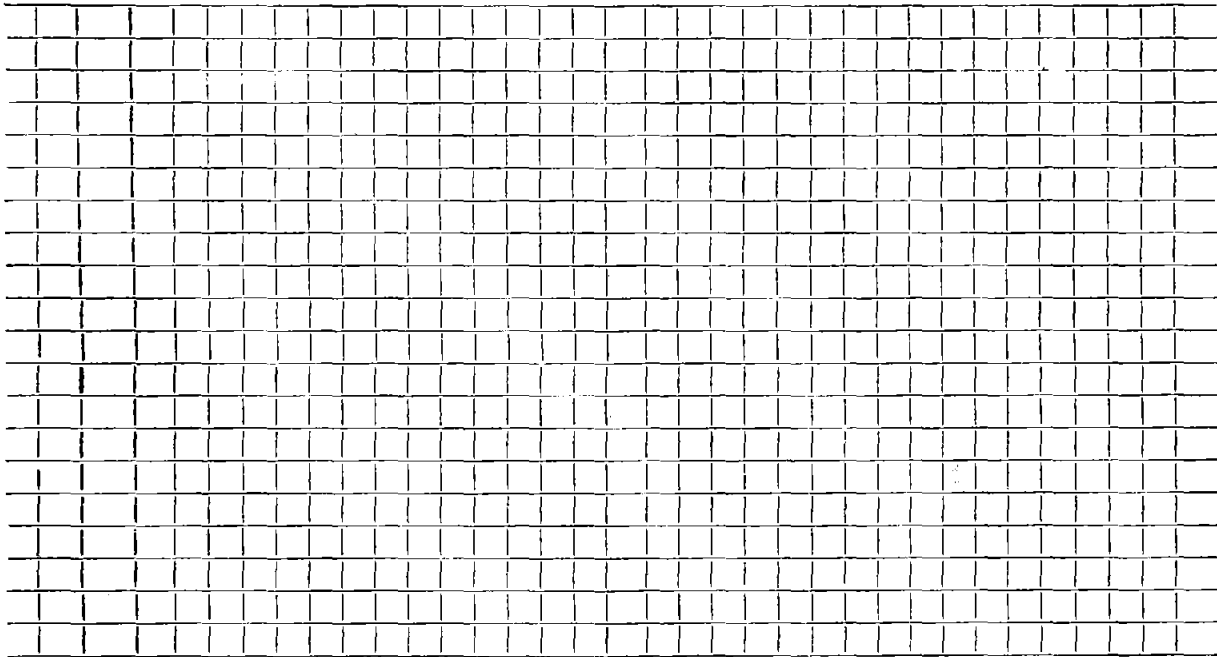

Connection made in ..... Street. Work completed .....

Remarks: .....  
.....  
.....