

Name Gustav Paterson

Service No. 109

Address 54 Cliffe Avenue

Location

Kind of Pipe

Size

Size of Main

Repair—Renewal—New Service

COM. 8-30-54

Location

Date	Material	Amount	Total	Date	Amount
7/24/54	Labor	42 96		6-30-54 Deposited	150 00
	10% Overhead	<u>4 30</u>	47 26	8-30-54 Refunded	(40 56)
1/6	6" Sewer Pipe @ .30		13 80		109 44
	1'-6"-1/4 Bend		1 24		
	1'-6"-Elbow		1 88		
	Joint Compound		2 76		
	1/2 Hrs. Littlefield Shovel	7.50	30 00		
	2 Hrs. Trucking @ .75		1 50		
	Patching 11 x 3		<u>11 00</u>		
			109 44		
	Labor				

TOWN OF LEXINGTON—DEPT. OF PUBLIC WORKS

SEWER DIVISION

DATE.....

NO.


The undersigned applies for the construction of a particular sewer connecting No.....
 Street and hereby agrees to comply with the Rules and Regulations governing the construction and use of Particular
 Sewers, as now or at any future time established by the Board of Selectmen.

Am't of estimate \$.....

Am't Paid \$.....

..... Owner

Sketch of Service Here **54**

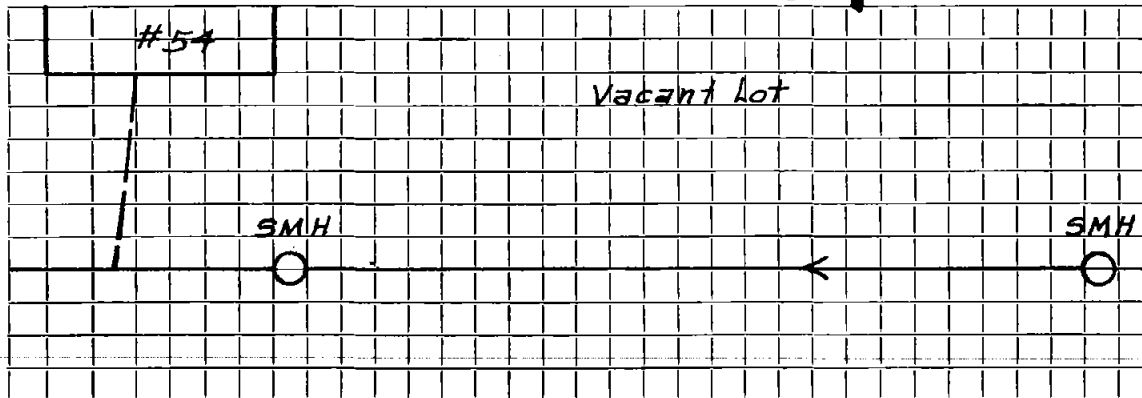

Connection made in..... Street.

Work completed.....19..

Remarks: