

Name George H. Parker, Jr.

Service No. 76

Address 58 Cliffe Ave.

Location

Kind of Pipe

Size

Size of Main

~~Repair~~ ~~Renewal~~ New Service

COM. 9-13-54

Location

Date	Material	Amount	Total	Date		Amount
6/29/54	Labor	89 35		5-18-54	Deposited	200 00
	10% overhead	8 94	98 29	9-13-54	Refunded	21 01
	128' - 6" sewer pipe @ .30		38 40		<u>NON CHARGE</u>	178 99
	1 - 6" elbow		1 88	6/30/54	Labor	89 35
	1 - 6" 1/8 bend		1 24			
	joint compound		7 68			
	6 hrs. town shovel @ 5.00		30 00			
	2 hrs. trucking @ .75		1 50			
			178 99			
	Labor					

TOWN OF LEXINGTON—DEPT. OF PUBLIC WORKS
SEWER DIVISION

DATE.....

NO.

The undersigned applies for the construction of a particular sewer connecting No.....
Street and hereby agrees to comply with the Rules and Regulations governing the construction and use of Particular
Sewers, as now or at any future time established by the Board of Selectmen.


Am't of estimate \$.....

Am't Paid \$.....

..... Owner

Sketch of Service Here

58

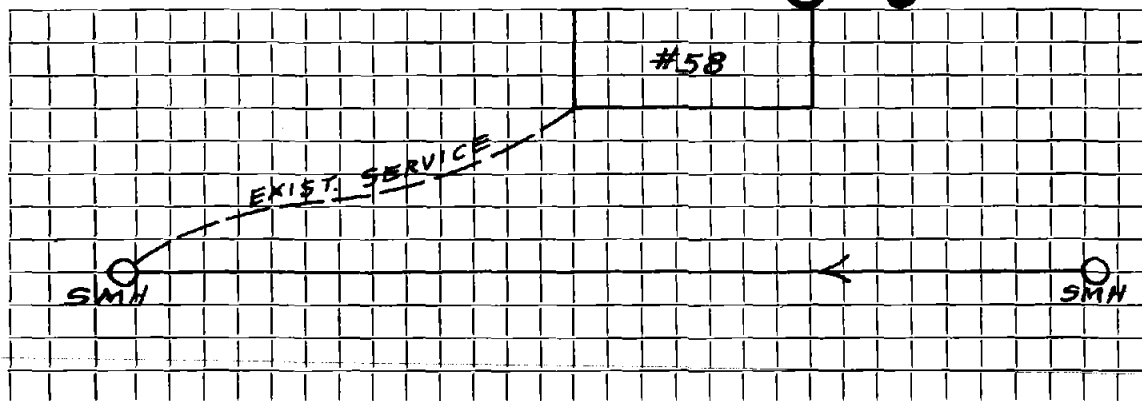

Connection made in Street.

Work completed.....19..

Remarks: