

Name Busa Boss.

Service No. 65

Address 61 Cliffe Avenue

Location

Kind of Pipe

Size

Size of Main

~~Repair-Renewal~~—New Service

Location *Comm 7-5-60*


Date	Material	Amount	Total	Date	Amount
5-12-60	Labor	23.91		5-3-60	380.00
5-13-60	"	114.72		7-5-60	43.89
5-14-60	"	24.36	162.99	1-4-60	146.36
	10% O.H.	16.30	179.29		490.25
	127' 6" Transite pipe @.78		99.06		
	8 ton Bank Gravel @.85		6.80		
	8 ton Fill @.70		5.60		
	9 hrs. Town Shovel @6.50		58.50		
	4 hrs. Trucking @3.00		12.00		
	3 hrs. Trojan Loader @3.00		9.00		
	Patching		120.00		
			490.25		

DATE _____

TOWN OF LEXINGTON — BOARD OF PUBLIC WORKS
SEWER DIVISION

Sketch of Service Here

61

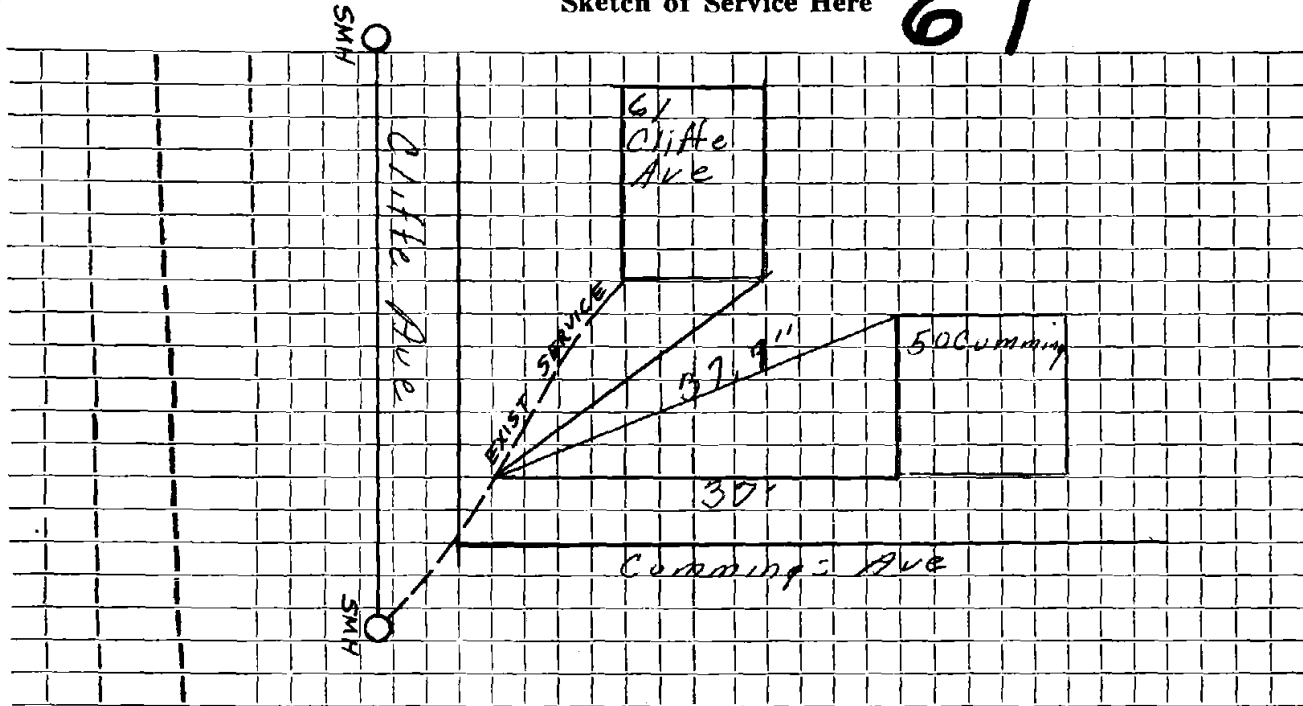

Connection made in Street. Work completed

Remarks: ... No. Tie from 61 Cliffe Ave. Given