




DATE \_\_\_\_\_

TOWN OF LEXINGTON — BOARD OF PUBLIC WORKS  
SEWER DIVISION

Sketch of Service Here

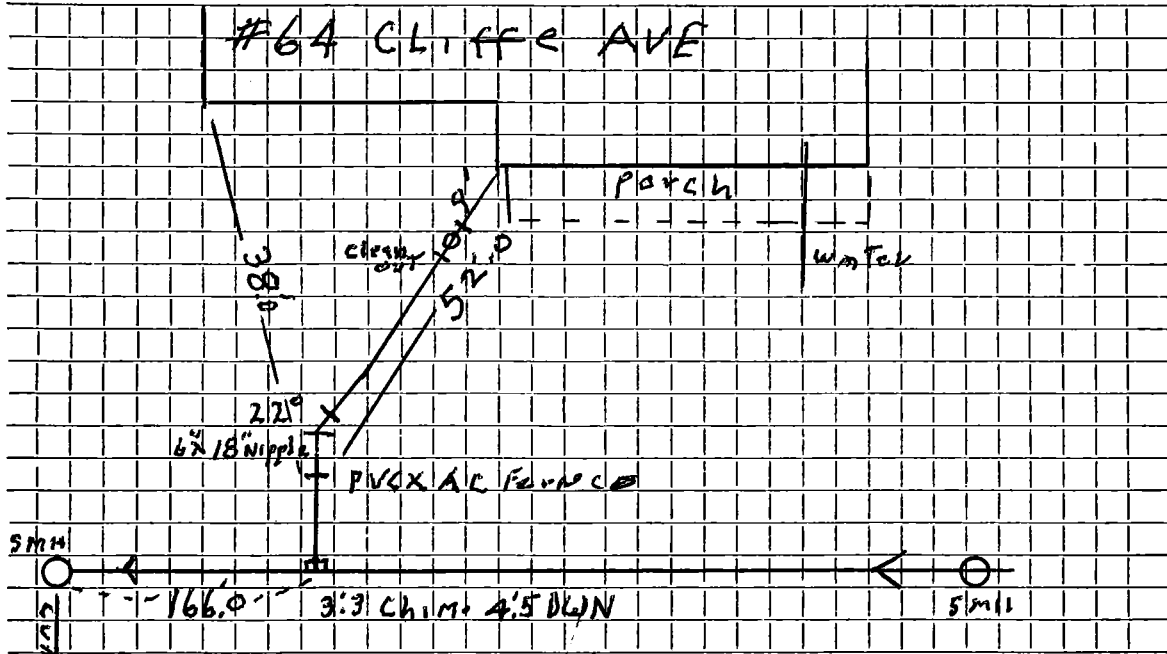

Connection made in 16th Street Street. Work completed 3/24/11

Remarks: .....

.....

.....