

Name Donald Green

Service No. 98

Address 70 Cliffe Avenue

Location

Kind of Pipe

Size

Size of Main

Repair—Renewal—New Service  
XXXXXXXXXXXXXXXX

W.O. # 9052 Valeri 1748

Location DEC 31 1970


Date	Material	Amount	Total	Date	Amount
	<b>Outside</b>				
10/22/70	Labor	81 92		11-6-70	160 00
11/6/70	"	14 31		1-18-71	46 97
11/6/70	"	14 57		<del>2-5-71</del>	206 97
	10% O.H.	11 08	121 88		
15'	6" Transite pipe	.90	13 50		
1	6" Saddle		5 50		
1	11 $\frac{1}{2}$ " Sweep		4 34		
2	Ton cold patch	6.00	12 00		
2	" Hot top	6.00	12 00		
4 $\frac{1}{2}$	Hrs. Trucking	3.00	13 50		
1 $\frac{1}{2}$	" "	1.50	75		
1	" Compressor	5.00	5 00		
1 $\frac{1}{2}$	" Loader	5.00	2 50		
2	" Shovel	6.50	13 00		
1 $\frac{1}{2}$	" Roller	2.00	1 00		
	Trailer		200		
	<b>Inside</b>		206 97		
10-23-70	27' 6" Transite pipe				
10	4" Cast Iron pipe				

DATE \_\_\_\_\_

TOWN OF LEXINGTON — BOARD OF PUBLIC WORKS

SEWER DIVISION

Sketch of Service Here **70**

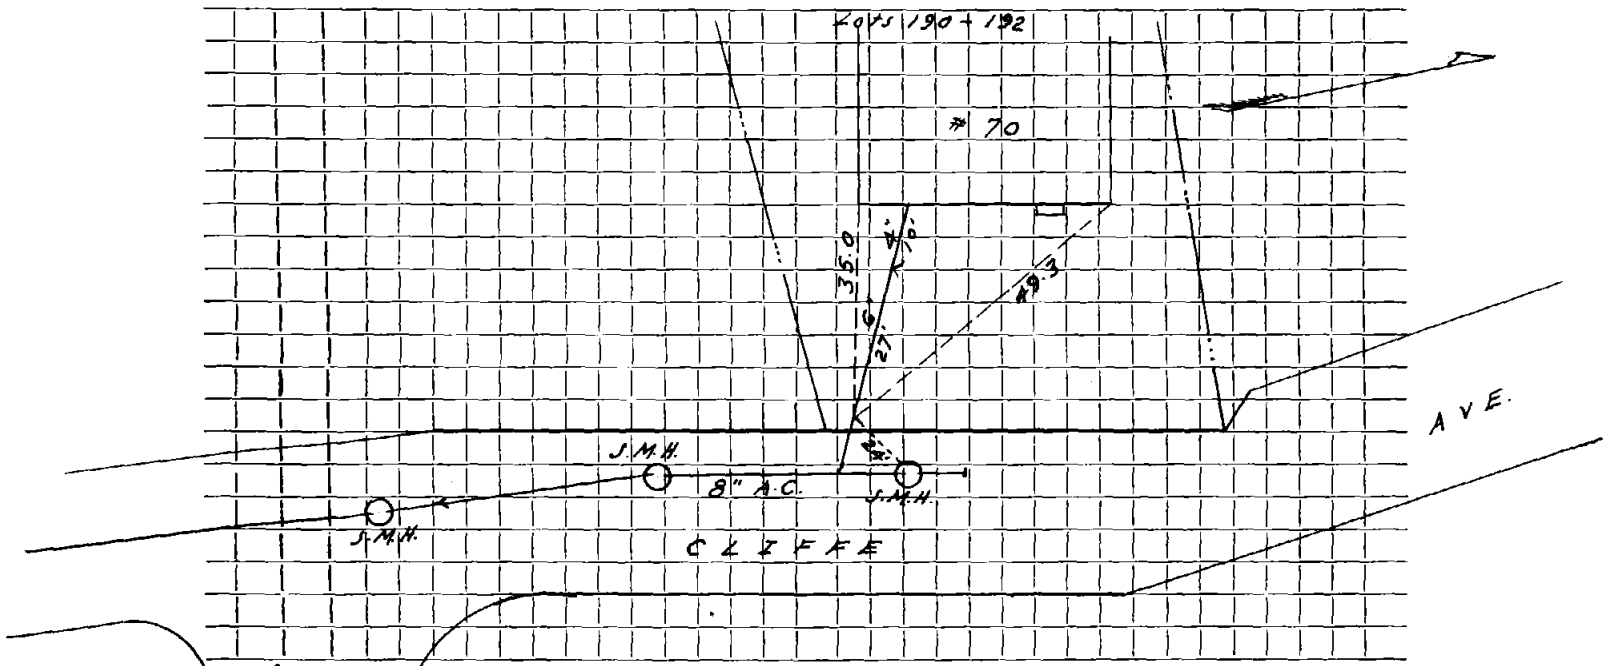

Connection made in \_\_\_\_\_ Street. Work completed \_\_\_\_\_

Remarks: \_\_\_\_\_  
\_\_\_\_\_  
\_\_\_\_\_

MELROSE  
AVE.