

Name

Service No.

Address # 82 CLIFFE AVE

Location

Kind of Pipe AC

Size 6"

Size of Main 8"

Repair—Renewal—New Service

Location


Date	Material	Amount	Total	Date	Amount
------	----------	--------	-------	------	--------

8/10/77	30'-6" ACP @	\$10.00	\$300.00		
---------	--------------	---------	----------	--	--

DATE 10/15/01

TOWN OF LEXINGTON — BOARD OF PUBLIC WORKS
SEWER DIVISION

Sketch of Service Here **82**

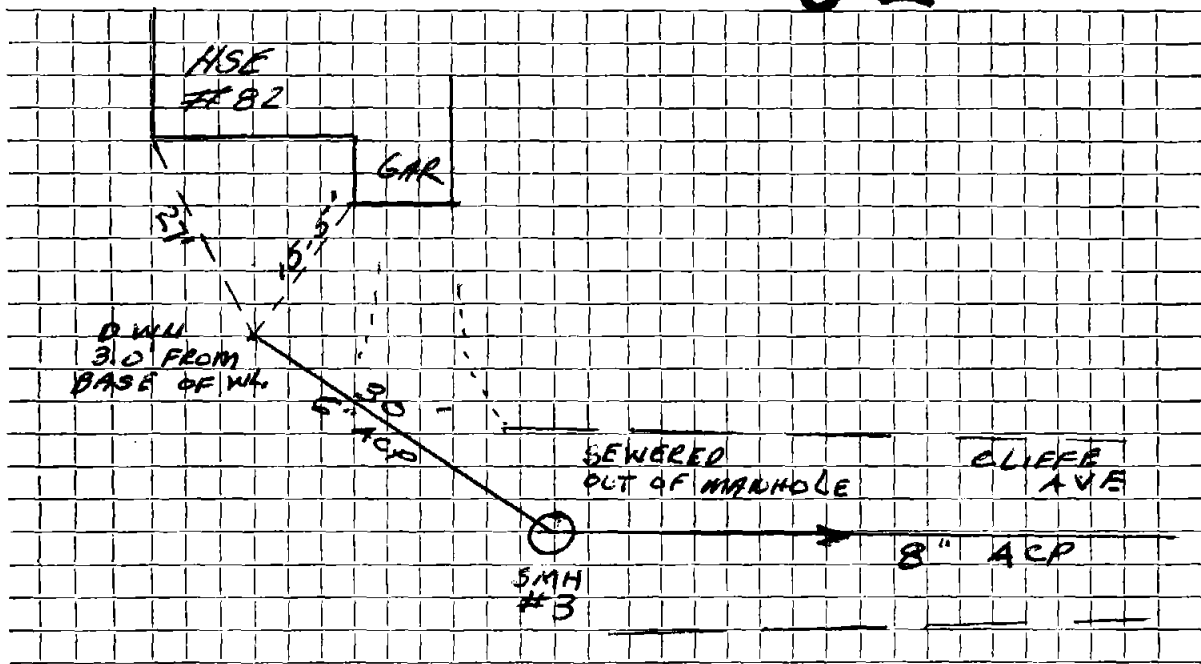

Connection made in Cliff Ave Street. Work completed

Remarks:
.....
.....