

DATE 5-17-50


TOWN OF LEXINGTON — BOARD OF PUBLIC WORKS

SEWER DIVISION

Sketch of Service Here

84

#84

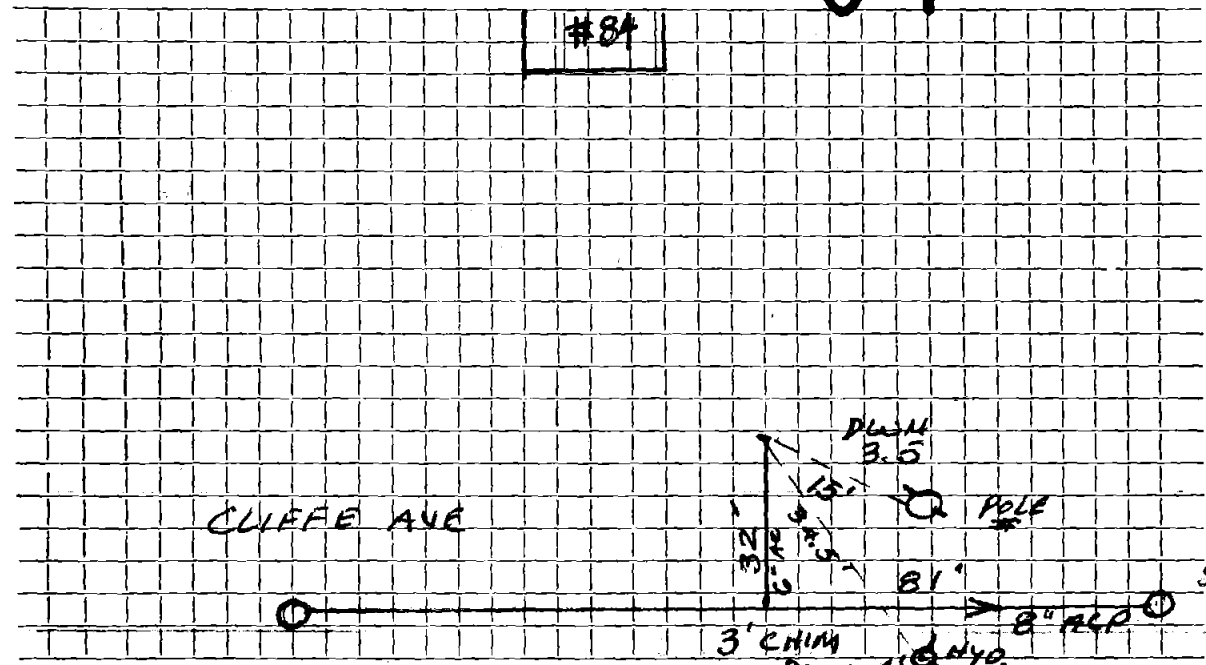

Connection made in Street.

Work completed

Remarks:
.....
.....