


DATE 8-19-77

TOWN OF LEXINGTON — BOARD OF PUBLIC WORKS
SEWER DIVISION

Sketch of Service Here

86

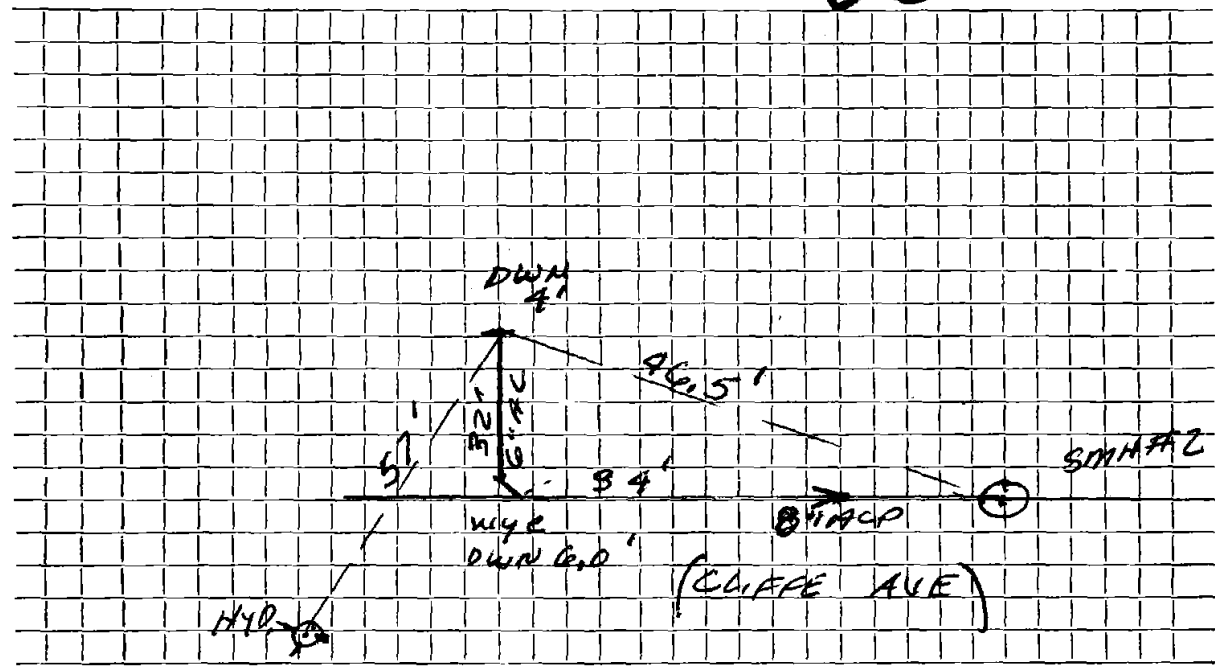

Connection made in Cliff Ave Street. Work completed

Remarks: