

Name Carman Scanga

Service No. 81

Address #88 CLIFFE AVE

Location

Kind of Pipe AC

Size 6"

Size of Main 8"

Repair—Renewal—New Service

DeFlice #3038

Location

FEB 13 1978

Date	Material	Amount	Total	Date	Amount	
9/16/77 9/11/77	26'-6" ACP @	*10.00	*260.00	9-14-77	Deposit	260.00
9/16/77	26' 6" ACP 10' - 4" CI					


DATE _____

TOWN OF LEXINGTON — BOARD OF PUBLIC WORKS

SEWER DIVISION

Sketch of Service Here

88

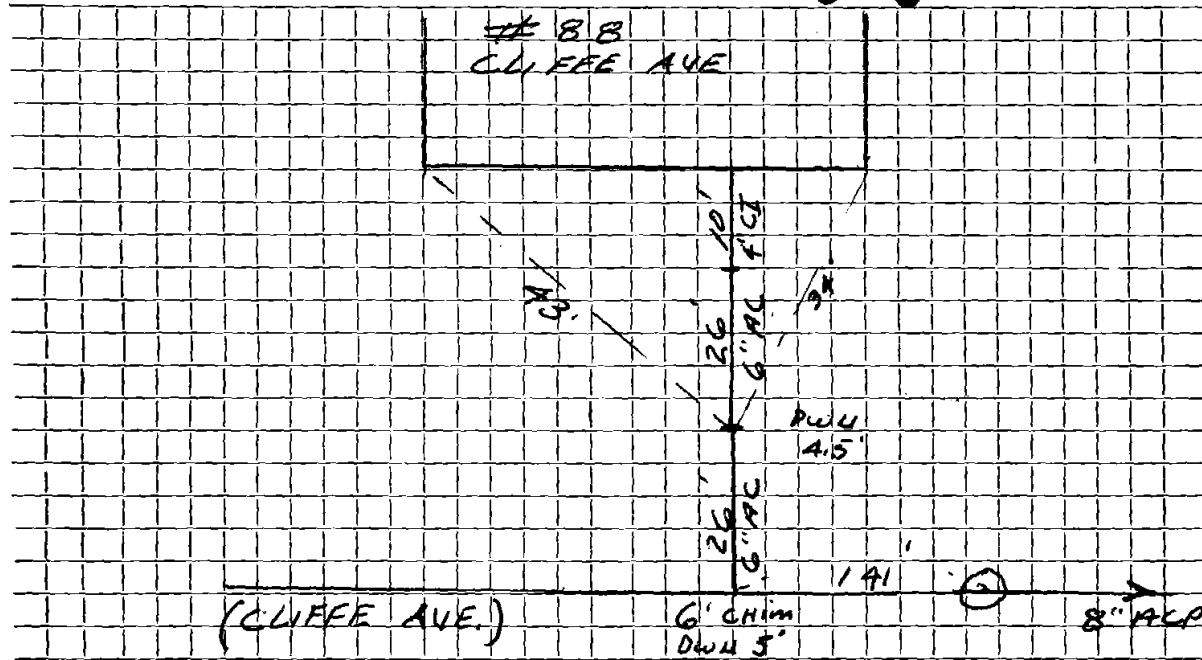

Connection made in ... CLIFFE AVE. ... Street. Work completed

Remarks:

.....

.....