


DATE 7-27-77

TOWN OF LEXINGTON — BOARD OF PUBLIC WORKS
SEWER DIVISION

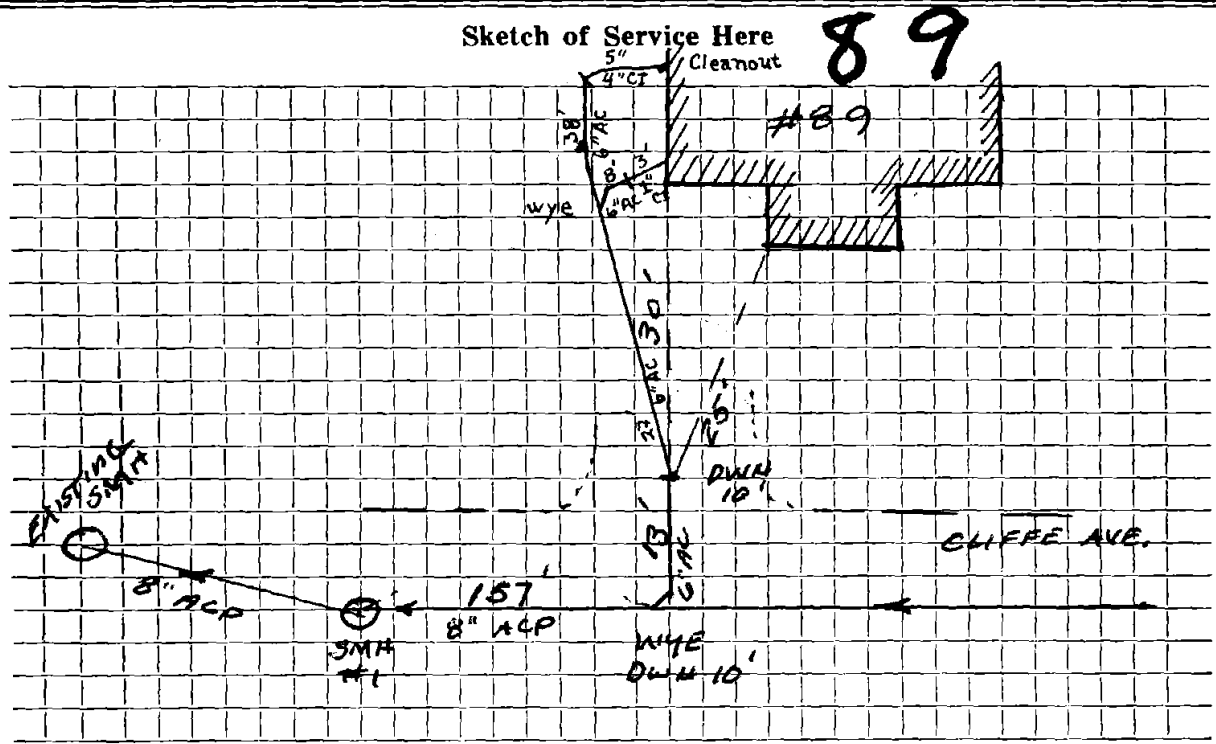

Connection made in Cliffe Ave. Street. Work completed

Remarks: