

Name Robert F. Hayes, Inc.

Service No. 41

Address VACANT LOT #9/ CLIFFE AVE

AUG 21 1978

Location

Kind of Pipe AC

Size 6"

Size of Main 8"

REPAIR REWORK - New Service Cincotta #3338

Location

Date	Material	Amount	Total	Date	Amount	
7/22/77	13' - 6" ACP @	\$ 10.00	\$ 130 00	8-14-78	Deposit	130 00
9-20-78	30' 6" Transite pipe					
	8' 4" Cast Iron pipe					
					REPAIR - Valeri #4983	
				8/4/87	2 4" Fernco used on iron pipe	


DATE 8-4-87

TOWN OF LEXINGTON — BOARD OF PUBLIC WORKS
SEWER DIVISION

Sketch of Service Here

91

Repair Made
8-4-87
2-4" Ferncos.
ON 4" IRON

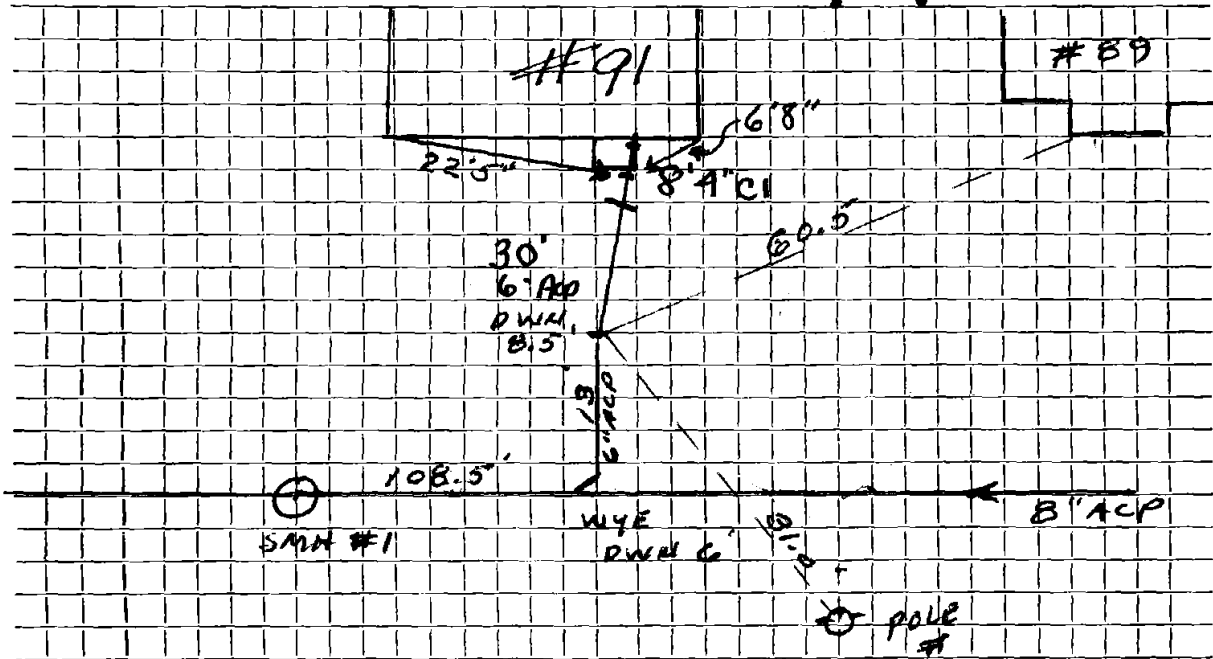

Connection made in Street. Work completed

Remarks:
.....
.....