

Name

Service No.

Address *VACANT LOT ~~311~~ CLIFFE AVE*

Location

Kind of Pipe *AC*

Size *6"*

Size of Main *8"*

Repair—Renewal—New Service

Location


Date	Material	Amount	Total		Date			Amount
<i>8/3/77</i>	<i>10' - 6" ACP @</i>	<i>\$10.00</i>	<i>\$100.00</i>					

DATE 8-21-77

# TOWN OF LEXINGTON — BOARD OF PUBLIC WORKS

## SEWER DIVISION

Sketch of Service Here

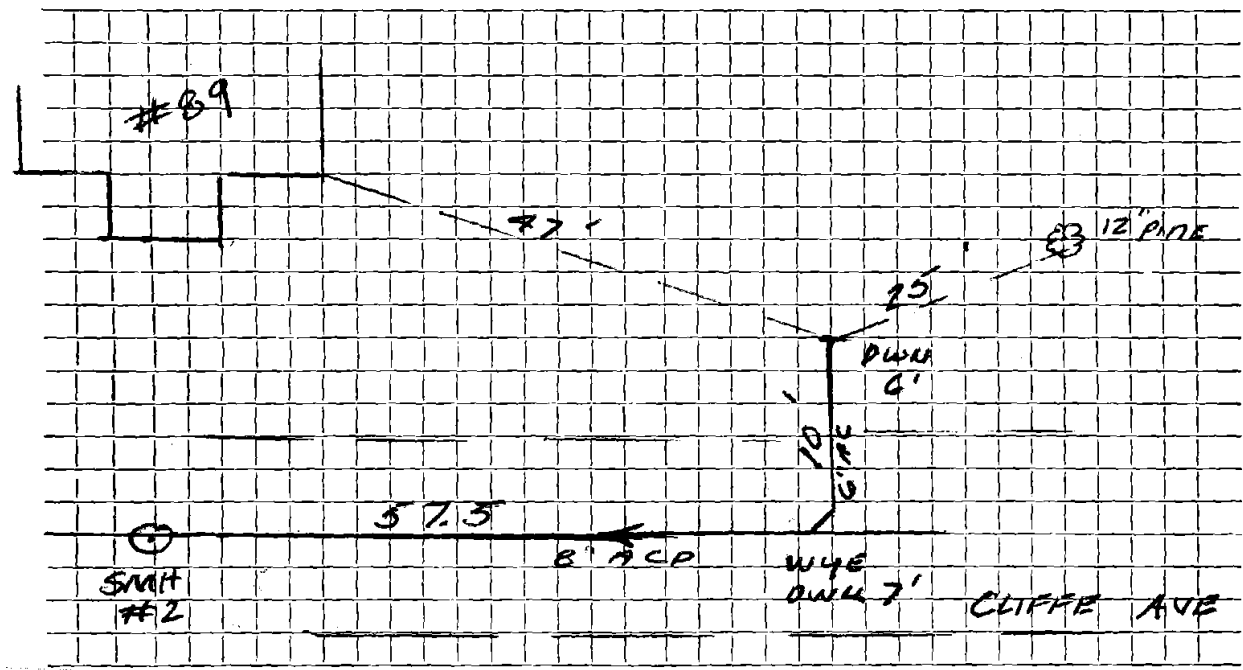

Connection made in Cliffe Ave Street. Work completed .....

Remarks: .....  
.....  
.....