

Name Kingston Homes Inc.

Service No.

Address <sup>2</sup>/<sub>4</sub> Clyde Place

Lot #22

Location

Kind of Pipe

Size

Size of Main

Repair—Renewal—New Service


Location

Date	Material	Amount	Total	Date	Amount
9/12/66	77' 6" Transite pipe				

DATE \_\_\_\_\_

**TOWN OF LEXINGTON — BOARD OF PUBLIC WORKS**  
**SEWER DIVISION**

Sketch of Service Here **4**

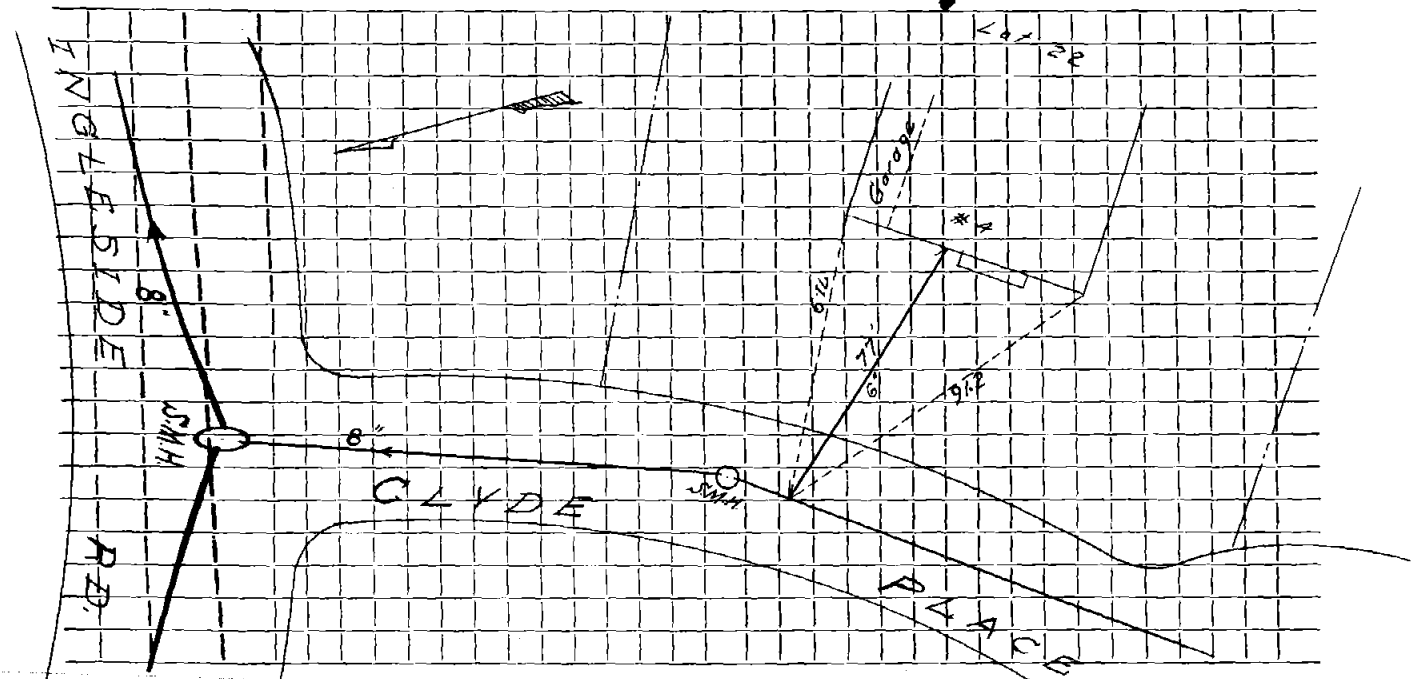

Connection made in ..... Street. Work completed .....

Remarks: .....  
.....  
.....