

Name James G. Burns

Service No. 10

Address 1 Couch Rd

Location

Kind of Pipe AC

Size 6"

Size of Main 8"

Repair—Renewal—New Service

Anthony Griecci Construction Co. #2808

Location AUG 16 1976


Date	Material	Amount	Total	Date	Amount
9-10-75	25' 6" AC @	\$10.00 =	\$250.00	3/29/76	Deposit 250 00
3/30/76	88' 6" Transite Pipe			9-10-75	
	5' 4" Cast Iron Pipe			25' 6" AC	

DATE

TOWN OF LEXINGTON - BOARD OF PUBLIC WORKS

SEWER DIVISION

Sketch of Service Here

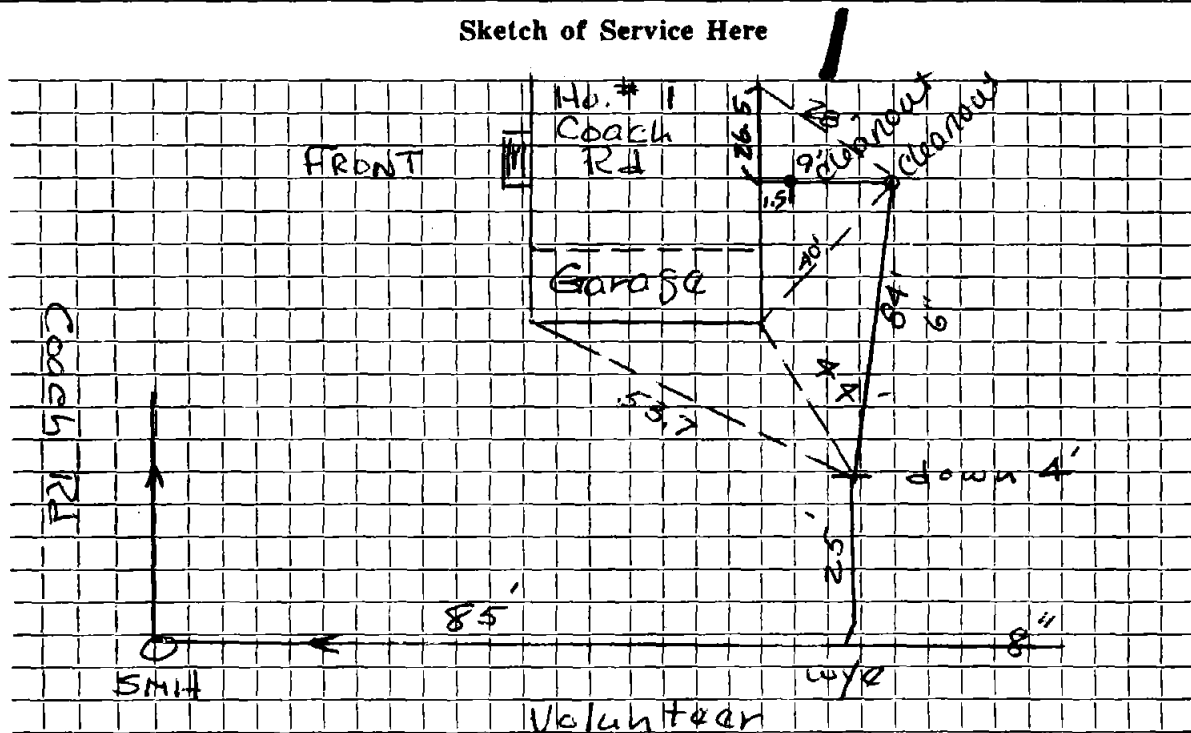

Connection made in Volunteer Way Street.

Work completed 3-30-76

Remarks: