

Name

Service No.

Address 2 Coach Rd. ? Assessors Lot # 90-129 (Vacant)

Location

Kind of Pipe AC

Size 6"

Size of Main 8"

Repair—Renewal—New Service

Location

Date	Material	Amount	Total	Date	Amount
------	----------	--------	-------	------	--------

<del>7-2-75</del>	22' 6" AC @	\$ 10.00	\$ 220.00		
-------------------	-------------	----------	-----------	--	--


				7-2-75	
				22' 6" AC	

DATE \_\_\_\_\_

TOWN OF LEXINGTON — BOARD OF PUBLIC WORKS

SEWER DIVISION

Sketch of Service Here

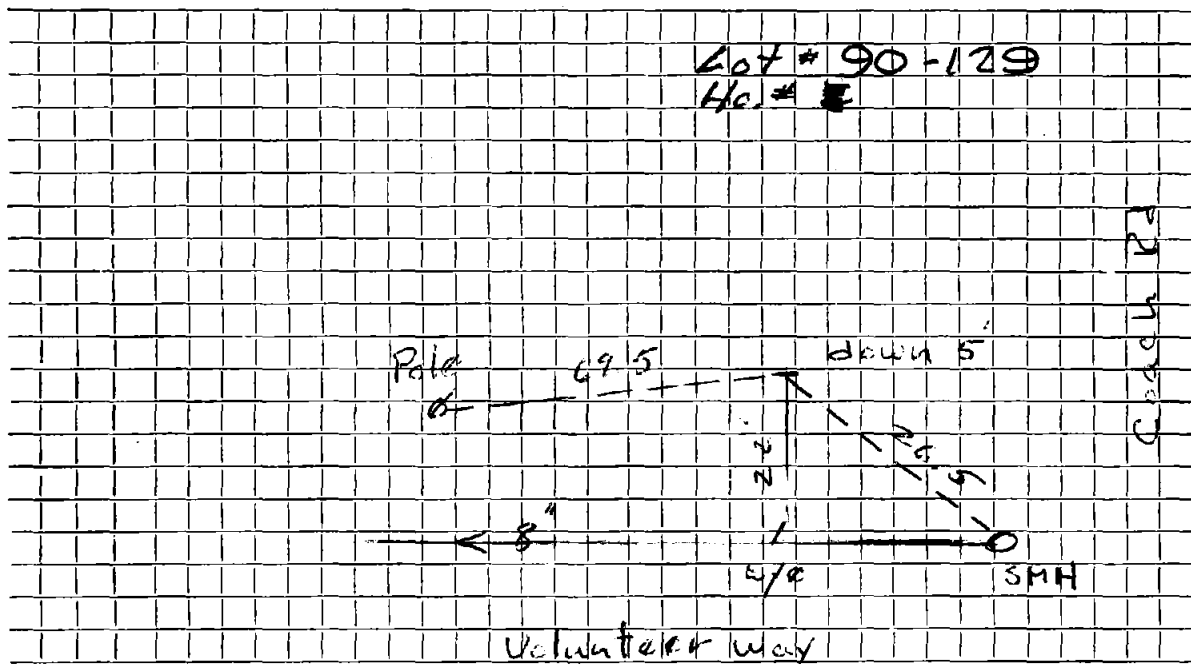

Connection made in Volunteer Way Street. Work completed .....

Remarks: .....

.....

.....