


DATE _____

TOWN OF LEXINGTON — BOARD OF PUBLIC WORKS

SEWER DIVISION

Sketch of Service Here

2

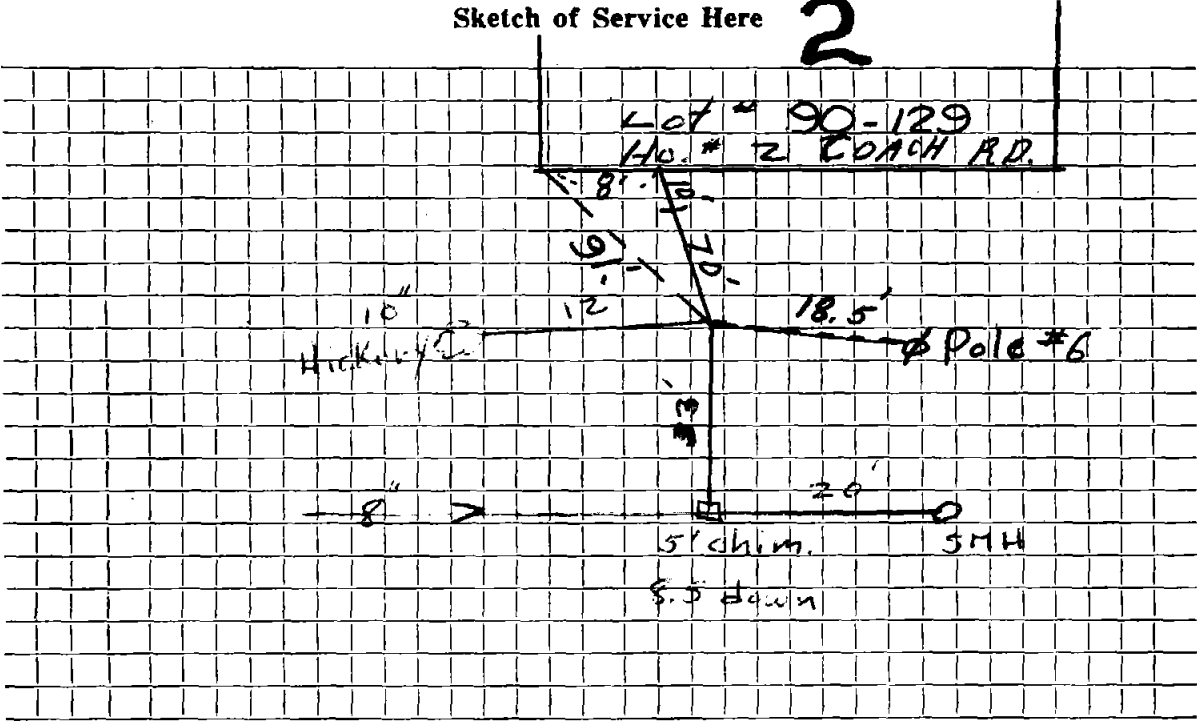

Connection made in Coach Rd. Street. Work completed

Remarks:
.....
.....