

Name Michael Saulich

Service No. 48

Address 4 COACH RD

AUG 6 1979

Location

Kind of Pipe A.C.

Size 6"

Size of Main 8"

~~Repair-Renewal~~ New Service Trebino #3401


Location

Date		Material	Amount		Total		Date		Amount	
7-31-75		29'-6" A.C.	\$10.	00	\$	290	00	7-2-79	Deposit	290 00
7/6/79	134	6" Transite Pipe								
	5	4" Cast Iron Pipe					7-31-75			
							29' 6" A.C.			

DATE _____

TOWN OF LEXINGTON — BOARD OF PUBLIC WORKS
SEWER DIVISION

Sketch of Service Here **4**

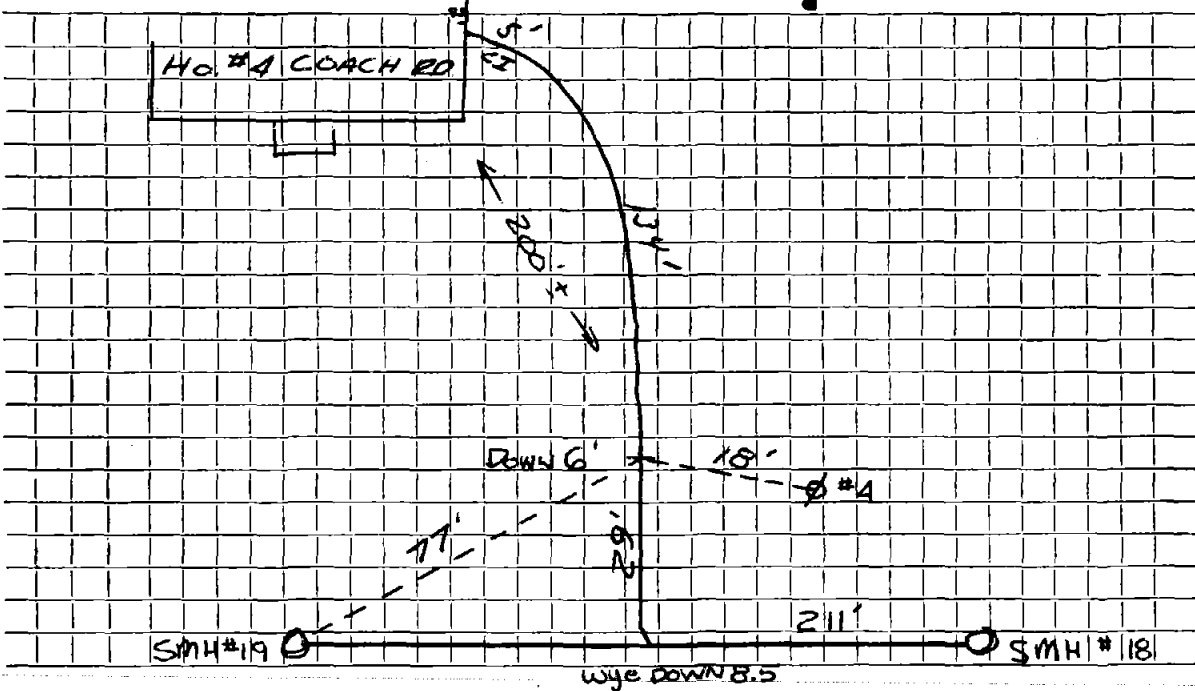

Connection made in COACH RD Street. Work completed

Remarks:
.....
.....