

Name John H. Holdsworth

Service No. 141

Address G COACH RD

Location

Kind of Pipe AC

Size 6"

Size of Main 8"

Repair—Renewal—New Service

Craftsman, Inc. #2780

Location AUG 16 1976

Date		Material	Amount		Total		Date		Amount	
7-31-75		29' 6" AC	\$ 10	00	\$ 290	00	11/17/75	Deposit	290	00
11/26/75	45'	6" Transite Pipe								
	10'	4" Cast Iron Pipe					7-31-75			
							29' 6" AC.			


DATE _____

TOWN OF LEXINGTON — BOARD OF PUBLIC WORKS

SEWER DIVISION

Sketch of Service Here

6

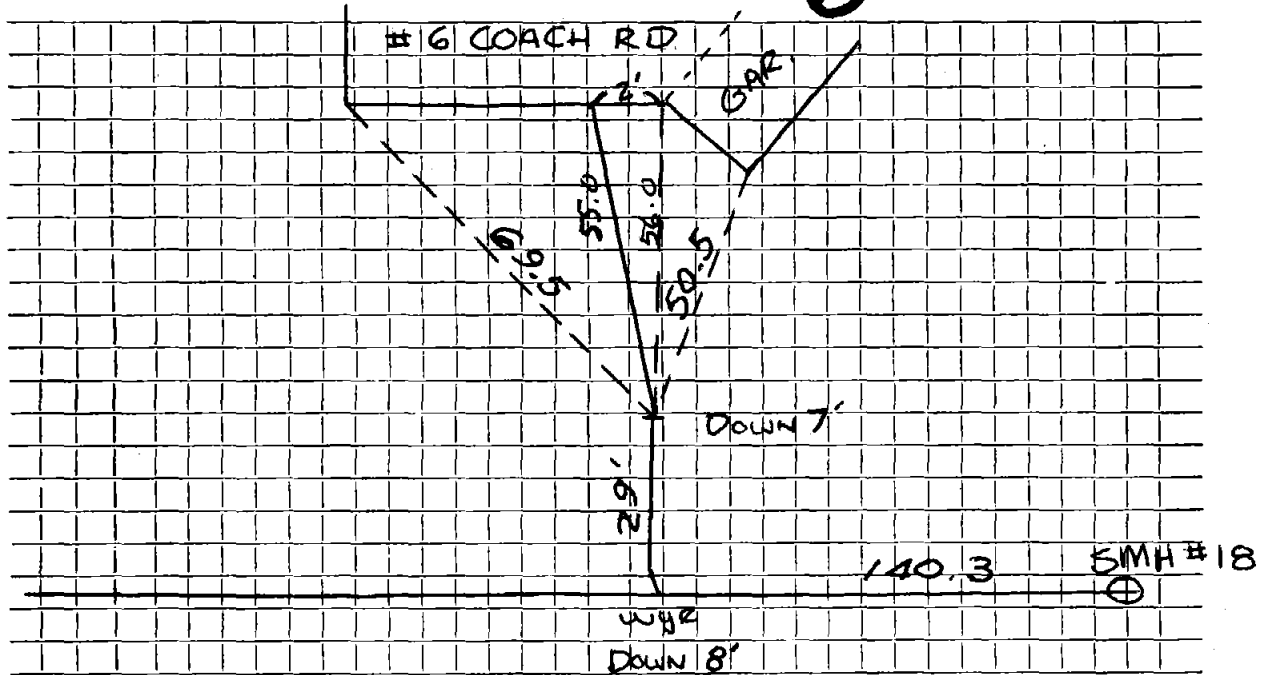

Connection made in COACH RD Street. Work completed 11-26-75

Remarks:

.....

.....