


DATE _____

TOWN OF LEXINGTON — BOARD OF PUBLIC WORKS
SEWER DIVISION

Sketch of Service Here **7**

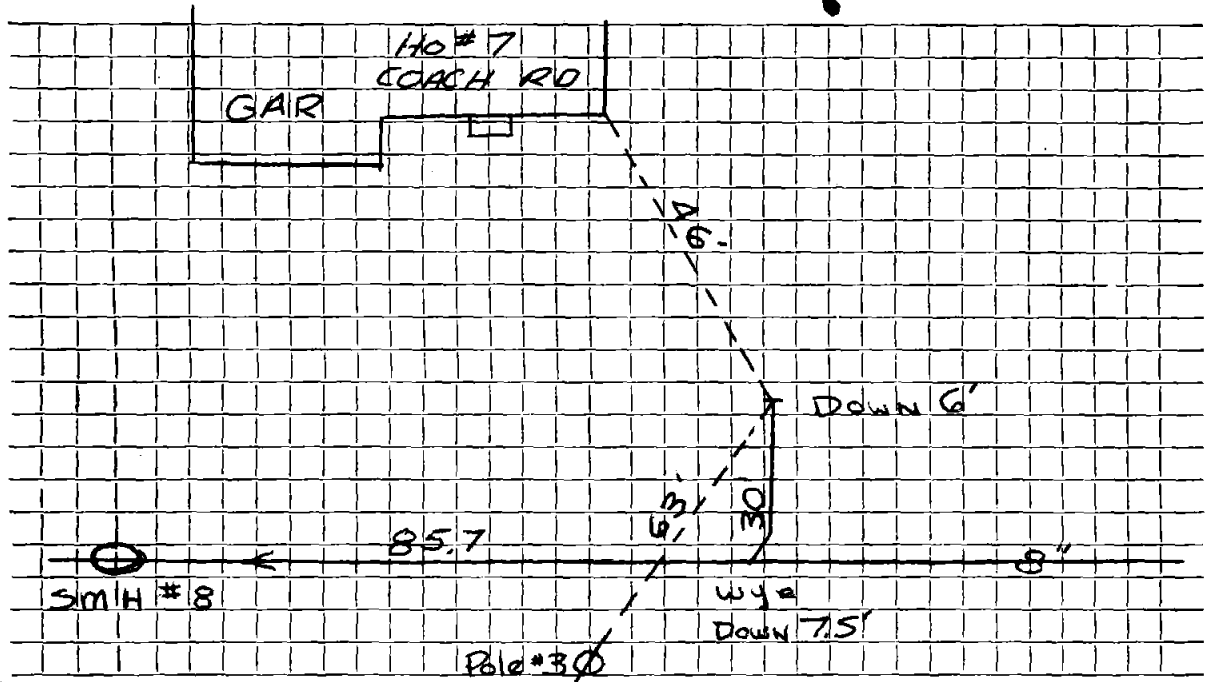

Connection made in COACH RD Street Work completed

Remarks:
.....
.....