

Name Robert Townsend

Service No. 143

Address 9 COACH RD

Location

Kind of Pipe AC

Size 6"

Size of Main 8"

Repair—Renewal—New Service Craftsman #2782


Location OCT 25 1976

Date		Material	Amount		Total	Date	Amount
7-30	75	29'-6" AC	# 10	00	\$290 00	11-21-75	Deposit
							290 00
						7-30-75	
						29' 6" AC.	

DATE \_\_\_\_\_

TOWN OF LEXINGTON — BOARD OF PUBLIC WORKS  
SEWER DIVISION

Sketch of Service Here **9**

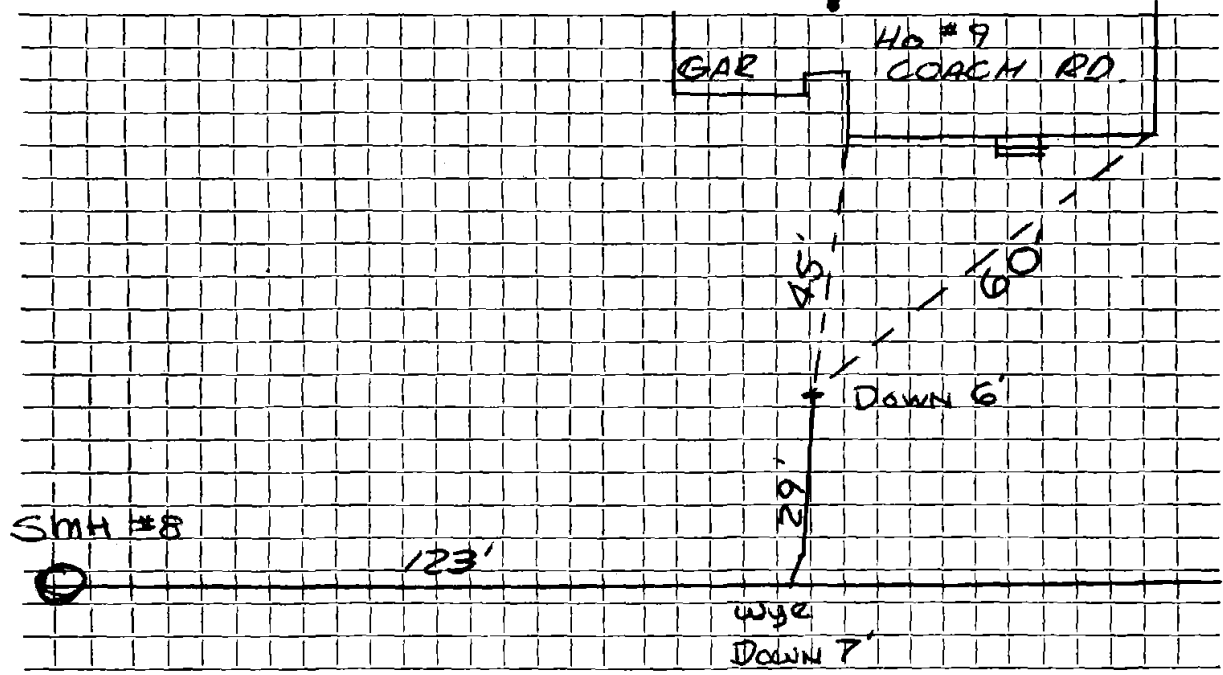

Connection made in COACH RD Street. Work completed .....

Remarks: .....  
.....  
.....