

Name Edward Ferri

Service No. 21

Address #10 COLONY RD.

Location

Kind of Pipe 6" Transite Pipe

Size 6"

Size of Main

~~Repair/Removal~~ — New Service W.O. #3233.

Tr. bind # 2425


Location NOV 24 1976

Date	Material	Amount	Total	Date	Amount
4-25-75	Labor	188.56		4-10-75	<i>Deposit</i>
	10% O.H.	18.86	\$207.42	10-24-75	<i>150.00</i>
20'	6" Transite Pipe @1.27		25.40		<i>2576.52</i>
1	5' x 6" Transite Pipe @1.48/Ft.		7.40		NON-CHARGE
1	6" x 6" Nipple		1.76	4-25-75	Labor
1	90° Elbow		5.63	1	Hr. Trucking
1	6" x 8" Cast Iron Saddle		11.97	1	Hr. Pickup
1 1/2	Ton Cold Patch @12.20		18.30		\$70.71
1	4' x 19' Patch		50.64		3.00
1	Hr. Trucking		3.00		1.50
1	Hr. Pickup		1.50		\$75.21
3	Hrs. Backhoe @6.50		19.50		
1	Hr. Loader		4.00		
<i>5-17-75</i>	<i>6" Transite</i>		<i>\$356.52</i>		
<i>15'</i>	<i>4" Cast Iron</i>				

DATE _____

TOWN OF LEXINGTON — BOARD OF PUBLIC WORKS
SEWER DIVISION

Sketch of Service Here **10**

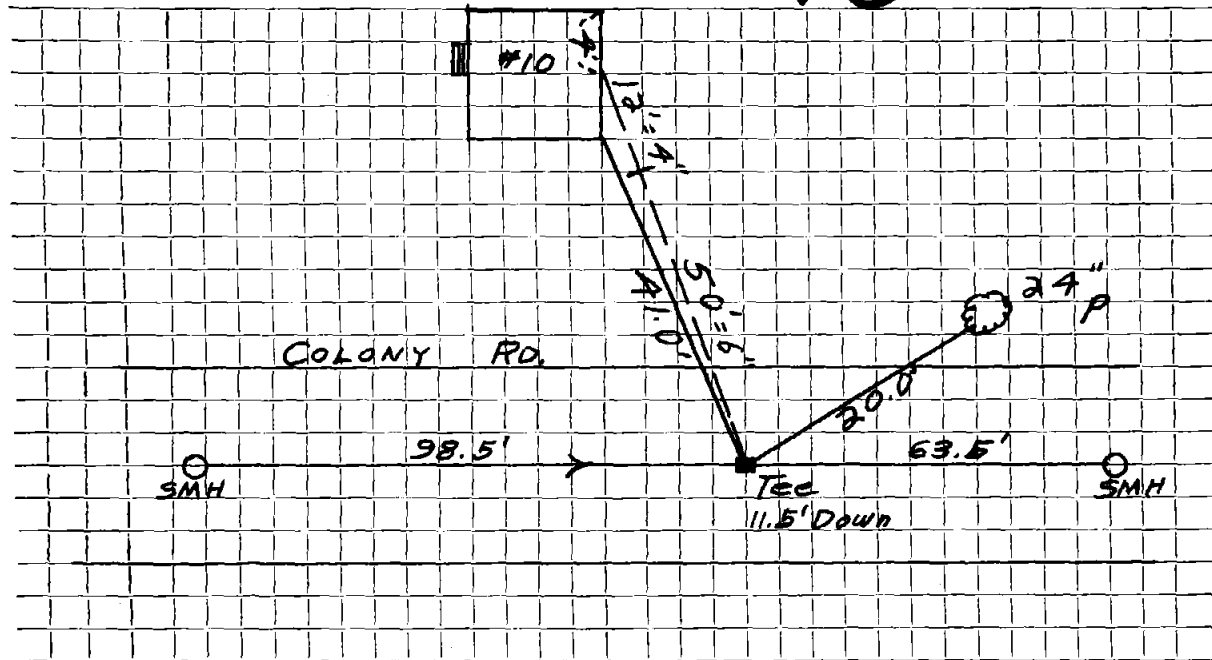

Connection made in Colony Street. Work completed

Remarks: