

Name Robert L. Henderson

Service No. 106

Address #14 COLONY RD.

Location

Kind of Pipe

Size

Size of Main

Repair—Renewal—New Service

W.O. #1248
Lexington Sewerage #2341


Location NOV 19 1973

Date		Material	Amount	Total	Date	Amount
9/26/73	30'	6" Transite Pipe			9-10-73	150.00
9/12/73		Labor	146.52			
10/19/73		"	19.61	166.13		
		10% O.H.	16.61	182.74		
	22'	6" Transite pipe @.99		21.78		
	1	6" Transite Elbow		4.89		
	1	6" x 6" Nipple		1.55		
	1	6" Adapter		1.77		
	½	bag Cement		.50		
	1	ton Cold Patch		8.00		
		18 x 4 Patch		48.00		
	1½	hr. Town Shovel @6.50		9.75		
	3	hrs. Trucking @3.00		9.00		
	1	hr. Loader		4.00		
	1	hr. Compressor		5.00		
				296.98		

DATE _____

TOWN OF LEXINGTON — BOARD OF PUBLIC WORKS
SEWER DIVISION

Sketch of Service Here **14**

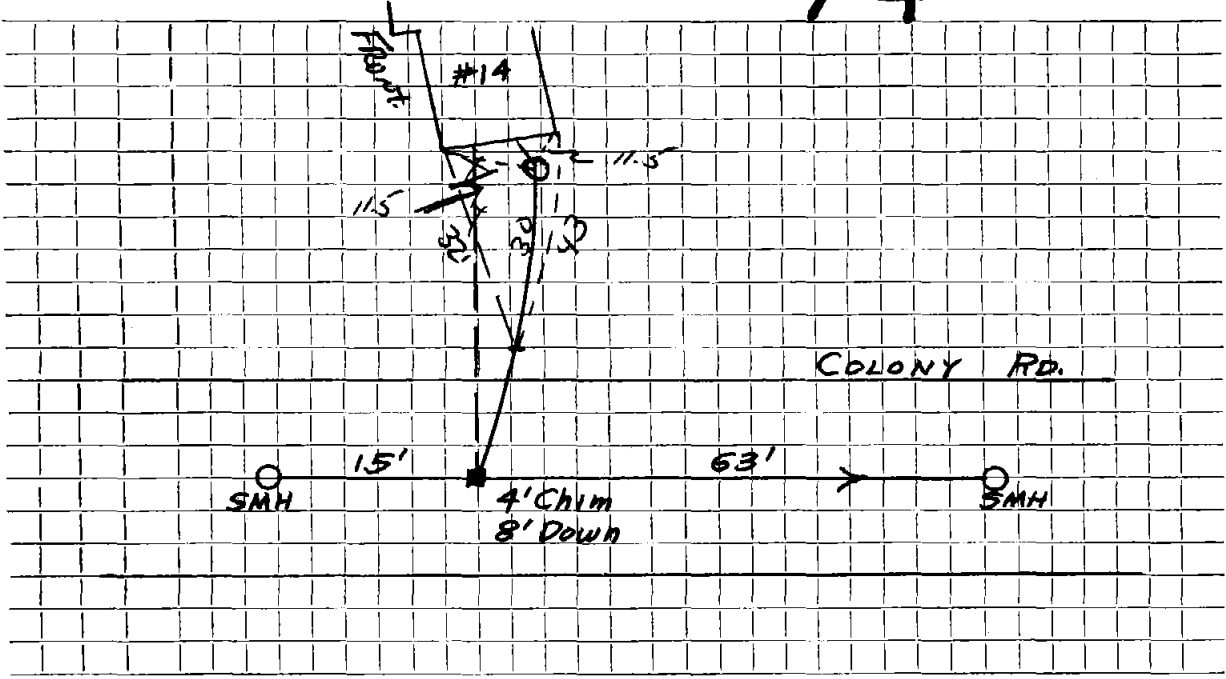

Connection made in Street. Work completed

Remarks:
.....
.....