

Name Millicent Taylor

Service No. 175

Address #17 COLONY RD.

Location

Kind of Pipe

Size

Size of Main

Repair—Renewal—New Service

Order # 7644

Location


Sum 12-10-62

Date	Material	Amount	Total	Date		Amount
11-14-62	Labor	90.92		10-30-62	Deposit	400.00
11-15-62	"	48.96	139.88	12-10-62	Re-Sund	69.32
	10% O.H.	13.99	153.87			330.68
	122" 6" Transite pipe @82		100.04			
	1 6" 90° Transite Elbow		4.09			
	2 11 1/4" Transite Bend @4.09		8.18			
	10 X 3 Patch		10.00			
	7 Hrs. Town Shovel @6.50		45.50			
	3 Hrs. Trucking @3.00		9.00			
			330.68			

DATE _____

TOWN OF LEXINGTON — BOARD OF PUBLIC WORKS
SEWER DIVISION

Sketch of Service Here **17**

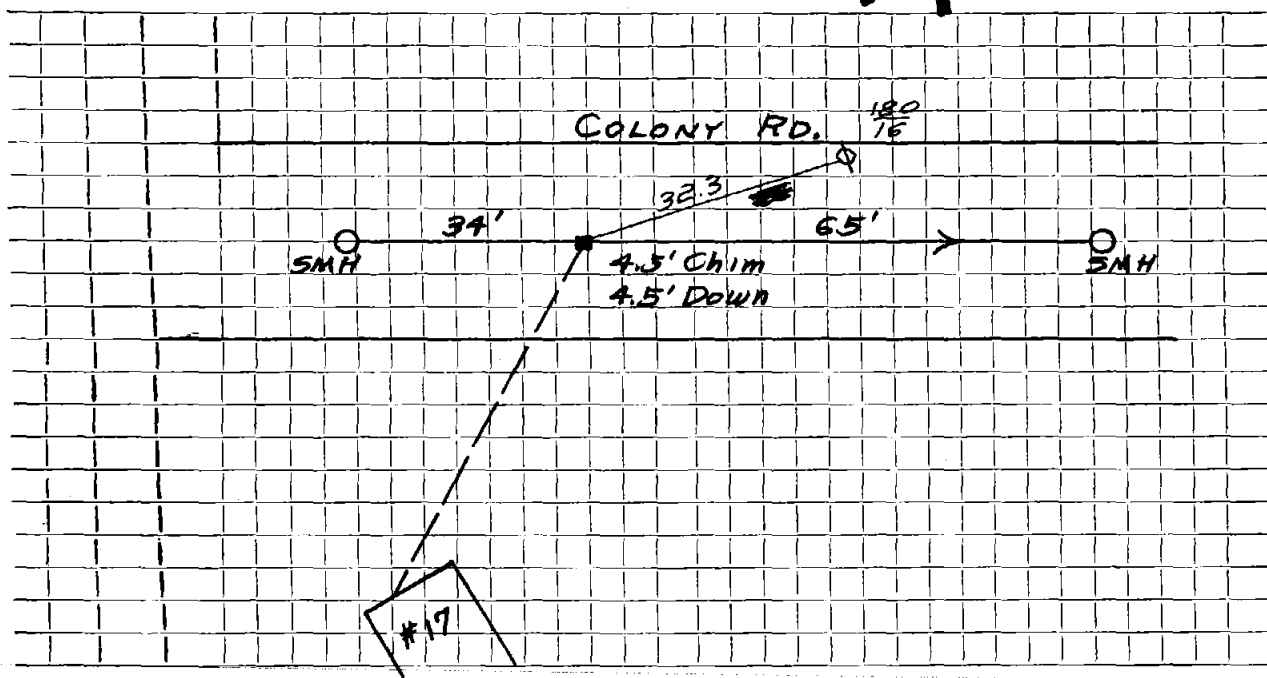

Connection made in Street. Work completed

Remarks:
.....
.....